

**SURVEY & REMONUMENTATION**

\$7.00  
\$2.00

MAR 03 1998

**SECTION**

**LAND CORNER RECORDATION CERTIFICATE**  
Filing Requirement of Act 74, Mich. P.A. 1970  
KENT COUNTY REMONUMENTATION

For corners in

Kent (County)	Located in: Grattan Township	Corner Code #
1. Public Land Survey	T <u>8N</u> R <u>9W</u>	<u>A-5</u>
	T _____ R _____	_____
	T _____ R _____	_____
	T _____ R _____	_____
2. Property Controlling in Section	S _____ T _____ R _____	_____
	S _____ T _____ R _____	_____
3. Miscellaneous Property in Sec.	S _____ T _____ R _____	_____
	S _____ T _____ R _____	_____


STATE OF MICHIGAN  
COUNTY OF KENT  
RECEIVED FOR RECORD  
97 NOV 14 AM 9:00  
REG. OF DEEDS  
*David Bond*

10299

Register of Deeds Stamp & File Number

4. Lot No. \_\_\_\_\_, Recorded Plat \_\_\_\_\_  
5. Private Claims \_\_\_\_\_

I, Randy Kolehouse, in a field survey on July 1 19 97, do hereby certify that under requirements of P.A. 74 Michigan P.A. of 1970, the corner points mentioned in lines 1 and 2 above were in conformance with regulations and rules therefore as required in the current manual of survey instructions of the United States Department of the interior, Bureau of Land Management or by a decree of a Court of Law and/or that the corner points mentioned in lines 3, 4 and 5 above were in conformance with the rules of the Michigan Board of Land Surveyors or by a Decree of a Court of Law; established, re-established, monumented, re-monumented, recovered, found as expressed below:

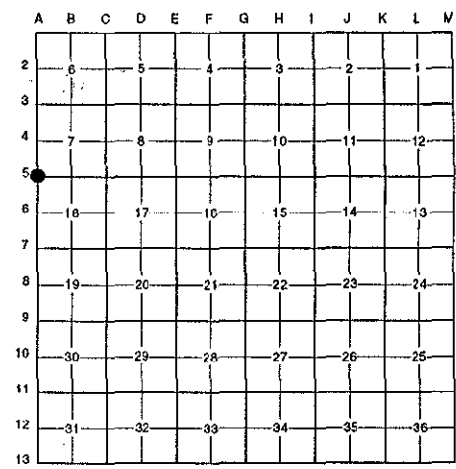

**NOTE: Not more than 4 corners, all in the same town and range, may be recorded on this certificate.**

**A. Description of original monument and accessories and/or subsequent restoration:**

A-5	1831	G.L.O. Notes	Mullett	Set Post
	N/A	Witness Map	K.C. Surveyor	Iron
	1971	L.C.R.C. #94	Williams & Works	2" Iron in Mon. Box (M-5, T8N, R10W)
	1973	L.C.R.C. #758	G. Fauser	Monument Box
	1981	L.C.R.C. #1901	Jonker Land Survey	Fnd. Iron in Mon. Box / Set K.C. Monument in Mon. Box (M-5, T8N, R10W)
	1989	L.C.R.C. #5290	J. Bueche	K.C. Monument in a Mon. Box (M-5, T8N, R10W)

Note: This corner is common with M-5, T8N, R10W.

This corner was originally approved by the Kent County Remonumentation Peer Group and monumented by Rob Jonker on 7/16/81 and was recorded per L.C.R.C. #1901.

**B. Description of corner evidence found and/or method applied in restoring or reestablishing corner:**

A-5 Found a Standard Kent County Monument in a monument box at the C/L intersection of Tiffany Avenue (gravel) running North and South and Belding Road (bit.) running East and West per L.C.R.C.'s #1901 and #5290 as set by Rob Jonker in place of a 1-1/2" x 30" iron he found in a monumetn box which checked L.C.R.C.'s #758, #94, and the K.C. Surveyor's records.

**L.C.R.C. #1901**

Remon. tag on E side p. pole N 16° W 146.88'  
Remon. tag on N side P. pole S 63° W 112.15'  
Remon. tag on N side p. pole S 70° E 205.4'  
NE cor. of back of curb N 19° E 68.10'  
NE cor. of back of curb N 64° E 64.85'

**L.C.R.C. #5290**

Remon. tag & nail on E side p. pole N 16° W 146.88'  
Remon. tag & nail on N side p. pole S 63° W 112.15'  
Remon. tag & nail on N side p. pole S 70° E 205.4'  
NE cor. of back of curb N 19° E 68.10'  
NE cor. of back of curb N 64° E 64.85'

The selected location is accepted by me and is generally accepted by professional surveyors as the best available evidence of the position of the original corner.

**C. Description of monument for corner and accessories established to perpetuate locating the position of the corner:**


A-5 Standard Kent County Monument in a Monument Box  
Nail & K.C. remon. tag on E side P. pole N 16° W 146.88'  
Nail & K.C. remon. tag on N side P. pole S 63° W 112.15'  
Nail & K.C. remon. tag on N side P. pole S 70° E 205.40'  
NE cor. of back of curb N 19° E 68.10'

P.A. 345 1990 KENT COUNTY

PEER APPROVED 9/28/97  
CHAIRMAN *Handwritten Signature*

Signed by Randy J. Kolehouse  
EARTH TECH

Date 9/23/97  
No. 25854

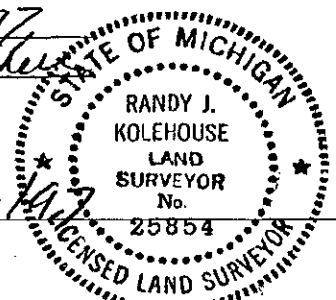

Surveyor's Michigan License No. 25854