

SURVEY & REMONUMENTATION

\$7.00
\$2.00

MAR 03 1998

SECTION

LAND CORNER RECORDATION CERTIFICATE
Filing Requirement of Act 74, Mich. P.A. 1970
KENT COUNTY REMONUMENTATION

For corners in

Kent (County)	Located in: Grattan Township	Corner Code #
1. Public Land Survey	T <u>8N</u> R <u>9W</u>	<u>A-6</u>
	T _____ R _____	_____
	T _____ R _____	_____
	T _____ R _____	_____
2. Property Controlling in Section	S _____ T _____ R _____	_____
	S _____ T _____ R _____	_____
3. Miscellaneous Property in Sec.	S _____ T _____ R _____	_____
	S _____ T _____ R _____	_____

4. Lot No. _____, Recorded Plat _____
5. Private Claims _____

STATE OF MICHIGAN
COUNTY OF KENT
RECEIVED FOR RECORD

97 NOV 14 AM 9:00


REG. OF DEEDS

Lucy Bond

10300

Register of Deeds Stamp & File Number

I, Randy Kolehouse, in a field survey on July 1 19 97, do hereby certify that under requirements of P.A. 74 Michigan P.A. of 1970, the corner points mentioned in lines 1 and 2 above were in conformance with regulations and rules therefore as required in the current manual of survey instructions of the United States Department of the interior, Bureau of Land Management or by a decree of a Court of Law and/or that the corner points mentioned in lines 3, 4 and 5 above were in conformance with the rules of the Michigan Board of Land Surveyors or by a Decree of a Court of Law; established, re-established, monumented, re-monumented, recovered, found as expressed below:

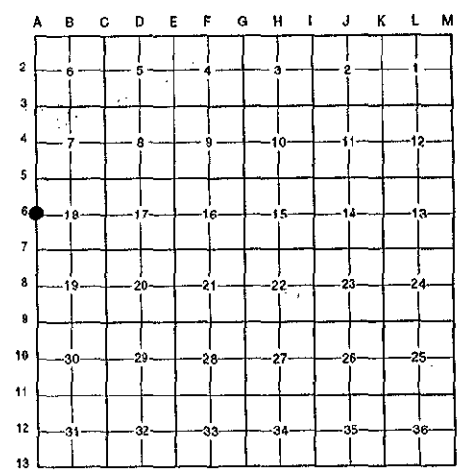

NOTE: Not more than 4 corners, all in the same town and range, may be recorded on this certificate.

A. Description of original monument and accessories and/or subsequent restoration:

A-6	1831	G.L.O. Notes	Mullett	Set Post
	1972	L.C.R.C. #162	Medema, Van Kooten & Assoc.	"T" Iron (M-6, T8N, R10W)
	1973	L.C.R.C. #758	G. Fauser	"T" Iron
	1981	L.C.R.C. #1902	Jonker Land Survey	Fnd. "T" Iron / Set K.C. Monument (M-6, T8N, R10W)
	1989	L.C.R.C. #5291	J. Bueche	K.C. Monument (M-6, T8N, R10W)

Note: This corner is common with M-6, T8N, R10W.

This corner was originally approved by the Kent County Remonumentation Peer Group and monumented by Rob Jonker on 7/16/81 and was recorded per L.C.R.C. #1902.

B. Description of corner evidence found and/or method applied in restoring or reestablishing corner:

A-6 Found a Standard Kent County Monument (.8' below grade) 3' West of the C/L of Tiffany Avenue (gravel) running North and South per L.C.R.C.'s #1902 and #5291 as set by Rob Jonker in place of a "T" iron he found which checked L.C.R.C.'s #758 and #162.

L.C.R.C. #1902	L.C.R.C. #5291
Remon. tag on E side 16" Oak S 22° W 64.09'	Remon. tag & nail on E side 18" Oak S 32° W 64.14'
Remon. tag on N side 36" Maple N 61° E 27.79'	Cut nail on N side 40" Maple N 61° E 27.79'
Remon. tag on N side 36" Maple S 87° E 33.88'	
Remon. tag on SW side 24" Oak S 42° E 50.53'	


P.A. 345 1990 KENT COUNTY
PEER APPROVED 8/28/97
CHAIRMAN *Harry Huber*

The selected location is accepted by me and is generally accepted by professional surveyors as the best available evidence of the position of the original corner.

C. Description of monument for corner and accessories established to perpetuate locating the position of the corner:

A-6 Standard Kent County Monument

Nail & K.C. remon. tag on E side 18" Oak S 22°s W 64.14'
Nail & K.C. remon. tag on N side 40" Maple N 61° E 27.79'
Nail & K.C. remon. tag on N side 40" Maple S 87° E 32.06'
Nail & K.C. remon. tag on SW side 26" Oak S 42° E 49.71'

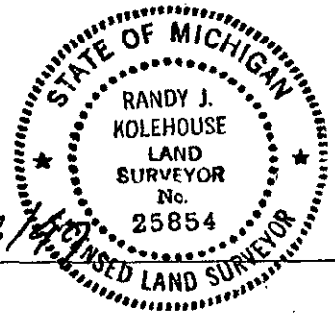

Signed by *Randy J. Kolehouse* Date 9/23/97
EARTH TECH

Surveyor's Michigan License No. 25854