SURVEY & REMONUMENTATION

$7.00
$2.00

MAR 0 3 1998

SECTION

STATE OF MICHIGAN
COUNTY OF KENT
RECEIVED FOR RECORD
97 NOV 14 AM 9:00
REG. OF DEEDS

LAND CORNER RECORDATION CERTIFICATE

Filing Requirement of Act 74, Mich. P.A. 1970

KENT COUNTY REMONUMENTATION

For corners in Kent (County) Located in: Grattan Township Corner Code #

1. Public Land Survey		T 8N	R 9W	A-7	
		T	R		
		T	R		
		T	R		
2. Property Controlling	S	T	R		
in Section	S	T	R		
3. Miscellaneous	S	T	R		
Property in Sec.	S	T	R		

10301

Register of Deeds Stamp & File Number

4. Lot No._____, Recorded Plat _____
5. Private Claims _____

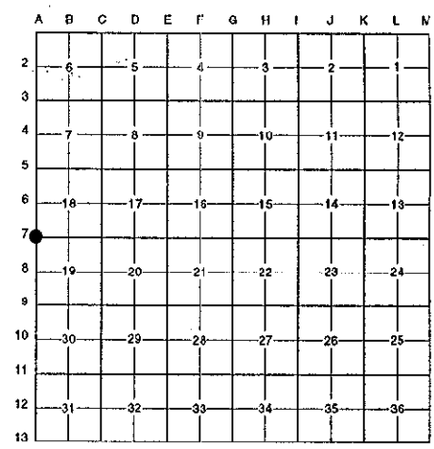

I, Randy Kolehouse, in a field survey on July 1 19 97, do hereby certify that under requirements of P.A. 74 Michigan P.A. of 1970, the corner points mentioned in lines 1 and 2 above were in conformance with regulations and rules therefore as required in the current manual of survey instructions of the United States Department of the interior, Bureau of Land Management or by a decree of a Court of Law and/or that the corner points mentioned in lines 3, 4 and 5 above were in conformance with the rules of the Michigan Board of Land Surveyors or by a Decree of a Court of Law; established, re-established, monumented, re-monumented, recovered, found as expressed below:

NOTE: Not more than 4 corners, all in the same town and range, may be recorded on this certificate.

A. Description of original monument and accessories and/or subsequent restoration:

A-7	1831	G.L.O. Notes	Mullett	Set Post
	N/A	Witness Map	K.C. Surveyor	Iron
	1972	L.C.R.C. #253	Williams & Works	Iron
	1973	L.C.R.C. #758	G. Fauser	1-1/4" Iron Pipe
	1982	L.C.R.C. #3111	Williams & Works	Fnd. 1-1/2" Iron / Set K.C. Monument
	1989	L.C.R.C. #5292	J. Bueche	K.C. Monument (M-7, T8N, R10W)

P.A. 345 1990 KENT COUNTY
PEER APPROVED 8/28/97
CHAIRMAN

Note: This corner is common with M-7, T8N, R10W.

This corner was originally approved by the Kent County Remonumentation Peer Group and monumented by Williams & Works on 10/18/82 and was recorded per L.C.R.C. #3111.

B. Description of corner evidence found and/or method applied in restoring or reestablishing corner:

A-7 Found a Standard Kent County Monument 2' West of the C/L of Tiffany Avenue (gravel) running North and South, 11' North of the C/L of a gravel road running West, on line of a fence running East and West per L.C.R.C.'s #3111 and #5292 as set by Williams & Works in place of a 1-1/2" iron they found in a ring of stones which checked L.C.R.C.'s #758, #253, and the K.C. Surveyor's records.

L.C.R.C. #3111

Nail & KC Remon tag in W side 8" Twin Wild Cherry S 10° E 80.03'
Nail & KC Remon tag in N side 1' diameter wood Fence Post E 22.65'

L.C.R.C. #5292

Nail & Remon. tag in E side 8" Triple Wild Cherry S 30° W 40.48'
Nail & Remon. tag in N side 1' diameter wood fence post S 22.65'

The selected location is accepted by me and is generally accepted by professional surveyors as the best available evidence of the position of the original corner.

C. Description of monument for corner and accessories established to perpetuate locating the position of the corner:

A-7 Standard Kent County Monument

Nail & K.C. remon. tag on S side 12" Oak N 70° W 40.70'
Nail & K.C. remon. tag on E side 8" Twin Hickory S 30° W 40.45'
Nail & K.C. remon. tag on E side 8" Triple W. Cherry S 50° W 40.48'
Nail & K.C. remon. tag on N side 1" dia. wood fence post East 22.65'

STATE OF MICHIGAN
RANDY J. KOLEHOUSE
LAND SURVEYOR
No. 25854
LICENSED LAND SURVEYOR

Signed by Randy J. Kolehouse Date 9/23/97
EARTH TECH

Surveyor's Michigan License No. 25854

FORM APPROVED BY MICHIGAN STATE BOARD OF LAND SURVEYORS, JAN. 28, 1971
REVISED MAY 14, 1975
REVISED JAN., 1983