

**SURVEY & REMONUMENTATION**

MAR 03 1998

\$7.00  
\$2.00

SECTION

**LAND CORNER RECORDATION CERTIFICATE**  
Filing Requirement of Act 74, Mich. P.A. 1970  
KENT COUNTY REMONUMENTATION

STATE OF MICHIGAN  
COUNTY OF KENT  
RECEIVED FOR RECORD  
97 NOV 14 AM 9:00  
REG. OF DEEDS  
*Lucy Stank*

For corners in


| Kent<br>(County)                      | Located in: Grattan<br>Township | Corner Code # |
|---------------------------------------|---------------------------------|---------------|
| 1. Public Land Survey                 | T <u>8N</u> R <u>9W</u>         | <u>A-9</u>    |
|                                       | T _____ R _____                 | _____         |
|                                       | T _____ R _____                 | _____         |
|                                       | T _____ R _____                 | _____         |
| 2. Property Controlling<br>in Section | S _____ T _____ R _____         | _____         |
|                                       | S _____ T _____ R _____         | _____         |
| 3. Miscellaneous<br>Property in Sec.  | S _____ T _____ R _____         | _____         |
|                                       | S _____ T _____ R _____         | _____         |

10303

Register of Deeds Stamp & File Number

4. Lot No. \_\_\_\_\_, Recorded Plat \_\_\_\_\_  
5. Private Claims \_\_\_\_\_

I, Randy Kolehouse, in a field survey on July 1 19 97, do hereby certify that under requirements of P.A. 74 Michigan P.A. of 1970, the corner points mentioned in lines 1 and 2 above were in conformance with regulations and rules therefore as required in the current manual of survey instructions of the United States Department of the interior, Bureau of Land Management or by a decree of a Court of Law and/or that the corner points mentioned in lines 3, 4 and 5 above were in conformance with the rules of the Michigan Board of Land Surveyors or by a Decree of a Court of Law; established, re-established, monumented, re-monumented, recovered, found as expressed below:

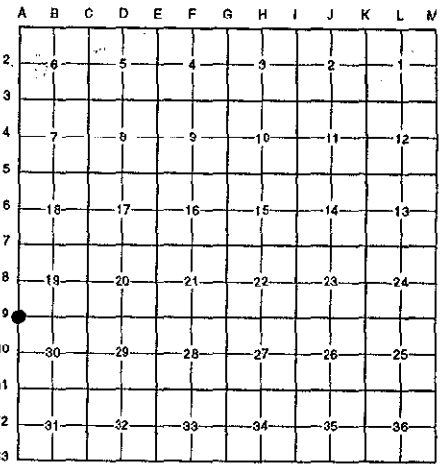

**NOTE: Not more than 4 corners, all in the same town and range, may be recorded on this certificate.**

A. Description of original monument and accessories and/or subsequent restoration:

|     |      |                |                    |  |
|-----|------|----------------|--------------------|--|
| A-9 | 1831 | G.L.O. Notes   | Mullett            | Set Post   |
|     | 1941 | Witness Map    | K.C. Surveyor      | Iron   |
|     | 1978 | L.C.R.C. #1151 | Williams & Works   | "T" Iron (M-9, T8N, R10W)                          |
|     | 1980 | L.C.R.C. #1403 | Williams & Works   | "T" Iron   |
|     | 1981 | L.C.R.C. #1904 | Jonker Land Survey | Fnd. "T" Iron / Set K.C. Monument (M-9, T8N, R10W) |
|     | 1989 | L.C.R.C. #5294 | J. Bueche          | K.C. Monument (M-9, T8N, R10W)                     |

P.A. 345 1990 KENT COUNTY  
PEER APPROVED 8/28/97  
CHAIRMAN Harry Huber

Note: This corner is common with M-9, T8N, R10W.

This corner was originally approved by the Kent County Remonumentation Peer Group and monumented by Rob Jonker on 7/17/81 and was recorded per L.C.R.C. #1904.

B. Description of corner evidence found and/or method applied in restoring or reestablishing corner:

A-9 Found a Standard Kent County Monument at the C/L intersection of Tiffany Avenue (gravel) running North and South and 6 Mile Road (gravel) running East and West per L.C.R.C.'s #1904 and #5294 as set by Rob Jonker in place of a "T" iron he found over a 2"x2"x2' solid point bar 1' below grade which checked L.C.R.C.'s #1403, #1151, and the K.C. Surveyor's records.

L.C.R.C. #1904

Remon. tag on NW side 18" Ash N 56° E 50.13'  
Remon. tag on NE side 21" Ash N 20° E 82.96'  
Remon. tag on NE side Triple 9" Hickory N 62° W 64.16'  
Remon. tag on SE side guy pole S 58° W 53.15'

L.C.R.C. #5294

Remon. tag & nail on SE side 12" Ash N 60° E 54.87'  
Remon. tag & nail on NE side 24" Ash N 20° E 82.88'  
Remon. tag & nail on NE side Triple 12" Hickory N 62° W 64.19'  
Remon. tag & nail on SE side guy pole S 58° W 53.15'  
Remon. tag & nail on SE side P.P. N 55° E 82.75'

The selected location is accepted by me and is generally accepted by professional surveyors as the best available evidence of the position of the original corner.

C. Description of monument for corner and accessories established to perpetuate locating the position of the corner:

A-9 Standard Kent County Monument

Nail & K.C. remon. tag on SE side 12" Ash N 60° E 54.87'  
Nail & K.C. remon. tag on NE side 12" Ash N 20° E 82.88'  
Nail & K.C. remon. tag on NE side Triple 12" Hickory N 62° W 64.19'  
Nail & K.C. remon. tag on SE side Guy pole S 58° W 53.15'

Signed by Randy J. Kolehouse Date 9/23/97

EARTH TECH

Surveyor's Michigan License No. 25854

