

SURVEY & REMONUMENTATION

MAR 03 1998

\$7.00
\$2.00

SECTION

LAND CORNER RECORDATION CERTIFICATE
Filing Requirement of Act 74, Mich. P.A. 1970
KENT COUNTY REMONUMENTATION

For corners in

Kent (County)	Located in:	Grattan Township	Corner Code #
1. Public Land Survey	T <u>8N</u>	R <u>9W</u>	<u>A-11</u>
	T _____	R _____	_____
	T _____	R _____	_____
	T _____	R _____	_____
2. Property Controlling in Section	S _____	T _____	R _____
	S _____	T _____	R _____
3. Miscellaneous Property in Sec.	S _____	T _____	R _____
	S _____	T _____	R _____

REG. OF DEEDS

Handwritten signature

97 NOV 14 AM 9:00

STATE OF MICHIGAN
COUNTY OF KENT
RECEIVED FOR RECORD

10305

Register of Deeds Stamp & File Number

4. Lot No. _____, Recorded Plat _____
5. Private Claims _____

I, Randy Kolehouse, in a field survey on June 30 19 97, do hereby certify that under requirements of P.A. 74 Michigan P.A. of 1970, the corner points mentioned in lines 1 and 2 above were in conformance with regulations and rules therefore as required in the current manual of survey instructions of the United States Department of the Interior, Bureau of Land Management or by a decree of a Court of Law and/or that the corner points mentioned in lines 3, 4 and 5 above were in conformance with the rules of the Michigan Board of Land Surveyors or by a Decree of a Court of Law; established, re-established, monumented, re-monumented, recovered, found as expressed below:

NOTE: Not more than 4 corners, all in the same town and range, may be recorded on this certificate.

A. Description of original monument and accessories and/or subsequent restoration:

A-11	1831	G.L.O. Notes	Mullett	Set Post
	1938	Witness Map	K.C. Surveyor	Monument
	1972	L.C.R.C. #130	Williams & Works	1" Iron in Mon. Box
	1982	L.C.R.C. #3113	Williams & Works	Fnd. 1" Iron in Mon. Box / Set K.C. Monument in Mon. Box
	1989	L.C.R.C. #5296	J. Bueche	K.C. Monument in Mon. Box (M-11, T8N, R10W)

P.A. 345 1990 KENT COUNTY
PEER APPROVED 8/28/97
CHAIRMAN Handwritten Signature

Note: This corner is common with M-11, T8N, R10W.

This corner was originally approved by the Kent County Remonumentation Peer Group and monumented by Williams & Works on 10/23/82 and was recorded per L.C.R.C. #3113.

B. Description of corner evidence found and/or method applied in restoring or reestablishing corner:

A-11 Found a Standard Kent County Monument 1' North and 2' West of the C/L intersection of 5 Mile Road (bit.) running East and West and Tiffany Avenue (bit. to gravel) running North per L.C.R.C.'s #3113 and #5296 as set by Williams & Works in place of a 1" iron they found in a monument box which checked L.C.R.C. #130 and the K.C. Surveyor's records.

L.C.R.C. #3113

L.C.R.C. #5296


Nail & KC Remon tag in side P. Pole N 35° E 85.35'
Nail & KC Remon tag in top center line Wood Fence Post South 52.70'
Top center line C. B. Cover N 35° W 71.77'
Southeasterly face large rock (measured at ground level) N 60° W 100.65'

Nail & Remon. tag in W side P. poee N 35° E 85.35'
Top C/L C.B. cover N 35° W 72.77'
"SE'y face large rock (measured at ground level) N 60° E 100.65'
Nail & Remon. tag top fence post S 40° E 75.58'

The selected location is accepted by me and is generally accepted by professional surveyors as the best available evidence of the position of the original corner.

C. Description of monument for corner and accessories established to perpetuate locating the position of the corner:

A-11 Standard Kent County Monument
Nail & K.C. remon. tag on W side P. pole N 35° E 85.35'
Top C/L C.B. cover N 35° W 72.77'
SE'y face large rock (measured at gnd. level) N 60° W 100.65'
Nail & K.C. remon. tag on top fence post S 40° E 75.58'

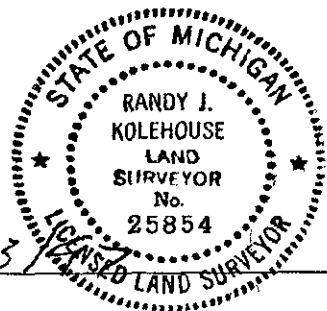

Signed by Randy J. Kolehouse Date 9/23/97
EARTHTECH

Surveyor's Michigan License No. 25854