

SURVEY & REMONUMENTATION

\$7.00
\$2.00

MAR 08 1999

LAND CORNER RECORDATION CERTIFICATE
Filing Requirement of Act 74, Mich. P.A. 1970
KENT COUNTY REMONUMENTATION

STATE OF MICHIGAN
COUNTY OF KENT
RECEIVED FOR RECORDS
38 DEC 23 AM 8:56
REG. OF DEEDS
David Standa

For corners in **SECTION**

Kent (County)	Located in: Grattan Township	Corner Code #
1. Public Land Survey	T <u>8N</u> R <u>9W</u>	<u>B-2</u>
	T _____ R _____	_____
	T _____ R _____	_____
	T _____ R _____	_____
2. Property Controlling in Section	S _____ T _____ R _____	_____
	S _____ T _____ R _____	_____
3. Miscellaneous Property in Sec.	S _____ T _____ R _____	_____
	S _____ T _____ R _____	_____

11070


Register of Deeds Stamp & File Number

- 4. Lot No. _____, Recorded Plat _____
- 5. Private Claims _____

I, Randy Kolehouse, in a field survey on November 2 19 98, do hereby certify that under requirements of P.A. 74 Michigan P.A. of 1970, the corner points mentioned in lines 1 and 2 above were in conformance with regulations and rules therefore as required in the current manual of survey instructions of the United States Department of the interior, Bureau of Land Management or by a decree of a Court of Law and/or that the corner points mentioned in lines 3, 4 and 5 above were in conformance with the rules of the Michigan Board of Land Surveyors or by a Decree of a Court of Law; established, re-established, monumented, re-monumented, recovered, found as expressed below:

NOTE: Not more than 4 corners, all in the same town and range, may be recorded on this certificate.

A. Description of original monument and accessories and/or subsequent restoration:
B-2 This corner was not originally set by the G.L.O.
No information on record for this corner.

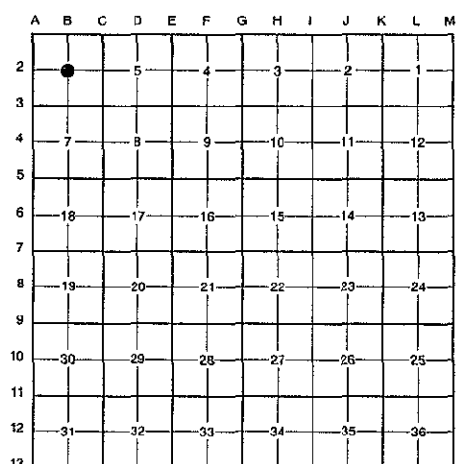


P.A. 345 1980 KENT COUNTY
PEER APPROVED 11/12/98
CHAIRMAN Harry Huber

B. Description of corner evidence found and/or method applied in restoring or reestablishing corner:
B-2 at intersection of 1/4 lines for this corner. Set a witness monument 3.23' East of intersection of 1/4 lines due to a large oak at the intended center. Monument is 4' ± South of an old fence line and tree row running West and 4' ± East of an old fence and tree row running South.

The selected location is accepted by me and is generally accepted by professional surveyors as the best available evidence of the position of the original corner.

C. Description of monument for corner and accessories established to perpetuate locating the position of the corner:

- B-2 Set a Standard Kent County Witness Monument
- Nail & K.C. remon. tag on S side 20" Oak S 84° W 2.84'
- Nail & K.C. remon. tag on E side 6' Maple North 3.66'
- Nail & K.C. remon. tag on S side 20" Oak N 88° E 10.14'
- Nail & K.C. remon. tag on NE'ly side 6' Maple S 40° E 19.00'
- Downed fence line and tree row running W, North 4' ±
- Downed fence line and tree row running S, West 4' ±

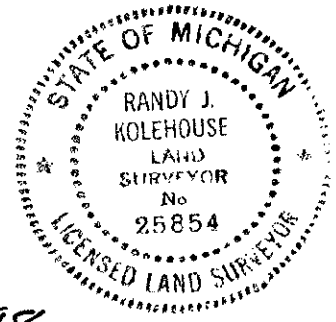

Signed by Randy J. Kolehouse
EARTH TECH

Date 12/14/98

Surveyor's Michigan License No. 25854