

SURVEY & REMONUMENTATION

MAR 08 1999

LAND CORNER RECORDATION CERTIFICATE
Filing Requirement of Act 74, Mich. P.A. 1970
KENT COUNTY REMONUMENTATION

\$7.00
\$2.00

STATE OF MICHIGAN
 COUNTY OF KENT
 RECEIVED FOR RECORD
 98 OCT 23 AM 9:58
 REG. OF DEEDS
David Bond


For corners in Kent (County) SECTION _____ Located in: Grattan Township Corner Code # _____

1. Public Land Survey	T <u>8N</u>	R <u>9W</u>	<u>B-3</u>
	T _____	R _____	_____
	T _____	R _____	_____
	T _____	R _____	_____
2. Property Controlling in Section	S _____	T _____	R _____
	S _____	T _____	R _____
3. Miscellaneous Property in Sec.	S _____	T _____	R _____
	S _____	T _____	R _____

4. Lot No. _____, Recorded Plat _____
 5. Private Claims _____

10826
 Register of Deeds Stamp & File Number

I, Randy Kolehouse, in a field survey on March 25 19 98, do hereby certify that under requirements of P.A. 74 Michigan P.A. of 1970, the corner points mentioned in lines 1 and 2 above were in conformance with regulations and rules therefore as required in the current manual of survey instructions of the United States Department of the Interior, Bureau of Land Management or by a decree of a Court of Law and/or that the corner points mentioned in lines 3, 4 and 5 above were in conformance with the rules of the Michigan Board of Land Surveyors or by a Decree of a Court of Law; established, re-established, monumented, re-monumented, recovered, found as expressed below:

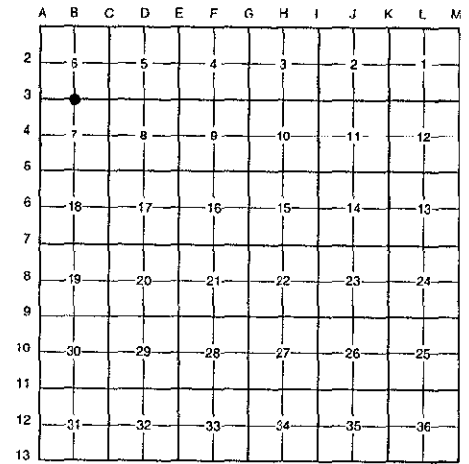

NOTE: Not more than 4 corners, all in the same town and range, may be recorded on this certificate.

A. Description of original monument and accessories and/or subsequent restoration:

B-3	1837	G.L.O. Notes	Cathcart	Set Post
	1898-1978	Notes	Williams & Works	Stone
	1978	L.C.R.C. #1122	Williams & Works	Stone
	1985	L.C.R.C. #4296	R. Kolehouse	Fnd. Ring of Stones / Set K.C. Monument
	1994	L.C.R.C. #7976	Glaza & Associates	K.C. Monument

This corner was originally approved by the Kent County Remonumentation Peer Group and monumented by Randy Kolehouse on 2/20/78 and was recorded per L.C.R.C. #4296.


B. Description of corner evidence found and/or method applied in restoring or reestablishing corner:
 B-3 Found a Standard Kent County Monument 2' East of a fence line running North and South and 4' ± North of a fence line running East and West per L.C.R.C.'s #4296 and #7976 as set by Randy Kolehouse in place of a ring of 6" stones 3' m/l in dia. and 3' m/l deep with the remains of a very old 1' dia. wood post in the center which checked the 1898 survey of Williams & Works.

L.C.R.C. #4296	L.C.R.C. #7976
Nail & K.C. Remon. tag in S. side 16" Oak N 50° W 20.00'	Nail & K.C. remon tag in S side 18" Oak N50°W 19.96' (m. 20.02')
Nail & K.C. Remon. tag in S. side 18" Maple S 75° E 13.87'	Nail & K.C. remon tag in S side 20" Maple S75°E 13.95' (m. 13.97')
Fence cor. (fences N.,S.,E. &W.) East 5'	Fence corner (fences N, S, E & W) East 5'

The selected location is accepted by me and is generally accepted by professional surveyors as the best available evidence of the position of the original corner.

C. Description of monument for corner and accessories established to perpetuate locating the position of the corner:
 B-3 Standard Kent County Monument
 Nail & K.C. remon. tag on S side 18" Oak N 50° W 20.02'
 Nail & K.C. remon. tag on S side 15" stump N 75° W 24.82'
 Nail & K.C. remon. tag on E side 20" Oak South 38.62'
 Nail & K.C. remon. tag on S side 20" Maple S 75° E 13.97'
 Fence line running N-S, West 2'
 Fence line running E-W, South 4'

P.A. 345 1990 KENT COUNTY
 PEER APPROVED 6/29/98
 CHAIRMAN *[Signature]*

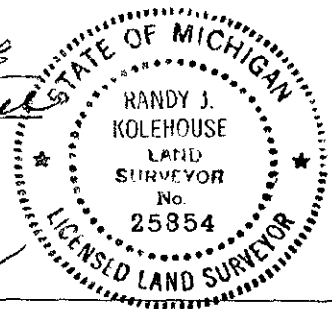

Signed by Randy J. Kolehouse Date 9-1-98
 Surveyor's Michigan License No. 25854