

SURVEY & REMONUMENTATION

MAR 08 1999

LAND CORNER RECORDATION CERTIFICATE
Filing Requirement of Act 74, Mich. P.A. 1970
KENT COUNTY REMONUMENTATION

STATE OF MICHIGAN
 COUNTY OF KENT
 RECEIVED FOR RECORD
 98 DEC 14 AM 8:00
 REG. OF DEEDS
Lucy Standa

For corners in Kent SECTION _____
 (County)

Located in: Grattan Township Corner Code # _____

1. Public Land Survey	T <u>8N</u>	R <u>9W</u>	<u>B-4</u>
	T _____	R _____	_____
	T _____	R _____	_____
	T _____	R _____	_____
2. Property Controlling in Section	S _____	T _____	R _____
	S _____	T _____	R _____
3. Miscellaneous Property in Sec.	S _____	T _____	R _____
	S _____	T _____	R _____

10963
 Register of Deeds Stamp & File Number

4. Lot No. _____, Recorded Plat _____
 5. Private Claims _____

A	B	C	D	E	F	G	H	I	J	K	L	M
2	6	5	4	3	2	1						
3												
4	8	9	10	11	12							
5												
6	18	17	16	15	14	13						
7												
8	19	20	21	22	23	24						
9												
10	30	29	28	27	26	25						
11												
12	31	32	33	34	35	36						
13												

I, Randy Kolehouse, in a field survey on February 5 19 98, do hereby certify that under requirements of P.A. 74 Michigan P.A. of 1970, the corner points mentioned in lines 1 and 2 above were in conformance with regulations and rules therefore as required in the current manual of survey instructions of the United States Department of the interior, Bureau of Land Management or by a decree of a Court of Law and/or that the corner points mentioned in lines 3, 4 and 5 above were in conformance with the rules of the Michigan Board of Land Surveyors or by a Decree of a Court of Law; established, re-established, monumented, re-monumented, recovered, found as expressed below:

NOTE: Not more than 4 corners, all in the same town and range, may be recorded on this certificate.

A. Description of original monument and accessories and/or subsequent restoration:

B-4 This corner was not originally set by the G.L.O.

1941	Witness Map	K.C. Surveyor	Stone
1978	L.C.R.C. #1177	Medema, Van Kooten & Assoc.	N/A
1978	Cert. Survey L. 136 P. 15-18	Medema, Van Kooten & Assoc.	1/2" Iron
1991	Cert. Survey L. 240 P. 14-15	C. Fricke	Iron

P.A. 345 1990 KENT COUNTY
 PEER APPROVED 10/22/98
 CHAIRMAN *[Signature]*

B. Description of corner evidence found and/or method applied in restoring or reestablishing corner:

B-4 Found a 1/2" iron pipe on the C/L of Whitten Road (gravel) running East and West, on line of a tree row running North, per L.C.R.C. #1177 and Cert. Surveys L. 136 P. 15-18 and L. 240 P. 14-15. Iron is 25.8' West and 4.0' South of the intersection of 1/4 lines. Accepted iron as Center of Section.

Cert. Survey L. 240 P. 14-15


- 10" Twin Maple S 60° E 60.15' (m. 60.20')
- 30" Maple N 8° E 41.8' (m. 41.95')
- 26" Maple N 68° E 67.0' (m. 66.97')
- 10" Poplar S 10° E 24.8' (m. 24.85')

The selected location is accepted by me and is generally accepted by professional surveyors as the best available evidence of the position of the original corner.

C. Description of monument for corner and accessories established to perpetuate locating the position of the corner:

B-4 Replaced 1/2" Iron with a Standard Kent County Monument

- Nail & K.C. remon. tag on E side 30" Maple N 16° E 41.95'
- Nail & K.C. remon. tag on SE side 28" Maple N 73° E 66.97'
- Nail & K.C. remon. tag on NE side tw. 8" Maple S 60° E 60.20'
- Nail & K.C. remon. tag on W side 10" Poplar S 13° E 24.85'
- C/L of gravel road running E-W
- On tree row running N

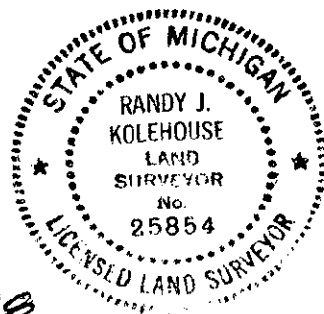

Signed by Randy J. Kolehouse
 EARTH TECH

Date 11/18/98

Surveyor's Michigan License No. 25854