

SURVEY & REMONUMENTATION

\$7.00
\$2.00

MAR 08 1999

LAND CORNER RECORDATION CERTIFICATE
Filing Requirement of Act 74, Mich. P.A. 1970
KENT COUNTY REMONUMENTATION

STATE OF MICHIGAN
COUNTY OF KENT
RECEIVED FOR RECORD
38 DEC 14 AM 8:00
REG. OF DEEDS
Eric Standa

For corners in


Kent (County)	SECTION	Located in:	Grattan Township	Corner Code #
1. Public Land Survey		T <u>8N</u>	R <u>9W</u>	<u>B-5</u>
		T _____	R _____	_____
		T _____	R _____	_____
		T _____	R _____	_____
2. Property Controlling in Section	S _____	T _____	R _____	_____
	S _____	T _____	R _____	_____
3. Miscellaneous Property in Sec.	S _____	T _____	R _____	_____
	S _____	T _____	R _____	_____

10964

Register of Deeds Stamp & File Number

4. Lot No. _____, Recorded Plat _____
5. Private Claims _____

I, Randy Kolehouse, in a field survey on October 14 19 98, do hereby certify that under requirements of P.A. 74 Michigan P.A. of 1970, the corner points mentioned in lines 1 and 2 above were in conformance with regulations and rules therefore as required in the current manual of survey instructions of the United States Department of the Interior, Bureau of Land Management or by a decree of a Court of Law and/or that the corner points mentioned in lines 3, 4 and 5 above were in conformance with the rules of the Michigan Board of Land Surveyors or by a Decree of a Court of Law; established, re-established, monumented, re-monumented, recovered, found as expressed below:

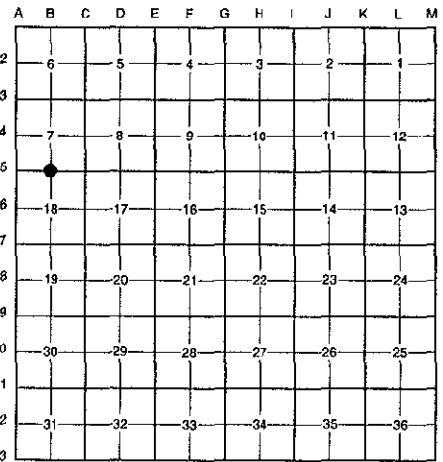

NOTE: Not more than 4 corners, all in the same town and range, may be recorded on this certificate.

A. Description of original monument and accessories and/or subsequent restoration:

B-5	1837	G.L.O. Notes	Cathcart	Set Post
	1930	Witness Map	K.C. Surveyor	1" Iron
	1972	L.C.R.C. #252	Williams & Works	1" Iron
	1973	L.C.R.C. #758	G. Fauser	Wood Post 2' Under Water
	1981	L.C.R.C. #2002	Jonker Land Survey	Fnd. 1/2" Iron / Set K.C. Monument
	1994	L.C.R.C. #7977	Glaza & Associates	K.C. Monument

P.A. 345 1990 KENT COUNTY
PEER APPROVED 9/24/98
CHAIRMAN Randy Kolehouse

This corner was originally approved by the Kent County Remonumentation Peer Group and monumented by Rob Jonker on 8/12/81 and was recorded per L.C.R.C. #2002.

B. Description of corner evidence found and/or method applied in restoring or reestablishing corner:

B-5 Found a Standard Kent County Monument in swamp under 4" of mud per L.C.R.C.'s #2002 and #7977 as set by Rob Jonker in place of a 1/2" iron he found inside of a 1-1/2" pipe 1" above grade which checked L.C.R.C. #252 and the K.C. Surveyor's records.

L.C.R.C. #2002

Remon. tag on NE side 16" Willow S 13° E 78.38'
Remon. tag on S side fe. Post N 75° E 4.40'
Remon. tag on NW side 12" Willow N 55° E 78.71'
1-1/2" pipe Westerly 0.85' (face)

L.C.R.C. #7977


K.C. remon tag & nail in NE side 16" Willow S 13° E 78.38' (m. 78.38')
K.C. remon tag & nail in S side fence post N 75° E 5.0' (m. 4.92')
K.C. remon tag & nail in NW side 14" Willow N 55° E 78.71' (m. 78.45')
1-1/2" pipe Westerly 0.85'
East edge of swamp 90' m/l East

The selected location is accepted by me and is generally accepted by professional surveyors as the best available evidence of the position of the original corner.

C. Description of monument for corner and accessories established to perpetuate locating the position of the corner:

B-5 Standard Kent County Monument

Nail & K.C. remon. tag on NE side 16" Willow S 13° E 78.38'
Nail & K.C. remon. tag on N side 10" Oak S 65° E 126.83'
Nail & K.C. remon. tag on NW side 18" Willow N 58° E 84.62'
Nail & K.C. remon. tag on NW side 14" Willow Stump N 55° E 78.45'
Nail & K.C. remon. tag on S side fence post N 75° E 4.92'
1-1/2" pipe, Westerly 0.85' (face)
East edge of swamp, East 90' m/l

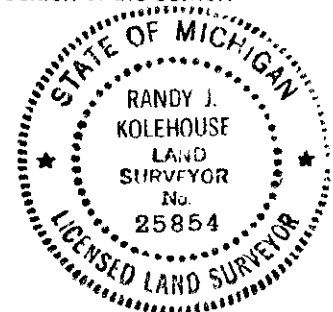

Signed by Randy J. Kolehouse
EARTH TECH

Date 11/18/98

Surveyor's Michigan License No. 25854