

\$7.00
\$2.00

MAR 08 1999

SECTION

LAND CORNER RECORDATION CERTIFICATE
Filing Requirement of Act 74, Mich. P.A. 1970
KENT COUNTY REMONUMENTATION

STATE OF MICHIGAN
COUNTY OF KENT
RECEIVED FOR RECORD
98 OCT 23 AM 9:58
REG. OF DEEDS
Lucy Stand

For corners in

Kent (County)	Located in: Grattan Township	Corner Code #
1. Public Land Survey	T <u>8N</u> R <u>9W</u>	<u>B-7</u>
	T _____ R _____	_____
	T _____ R _____	_____
	T _____ R _____	_____
2. Property Controlling in Section	S _____ T _____ R _____	_____
	S _____ T _____ R _____	_____
3. Miscellaneous Property in Sec.	S _____ T _____ R _____	_____
	S _____ T _____ R _____	_____
4. Lot No. _____, Recorded Plat _____		
5. Private Claims _____		

10827

Register of Deeds Stamp & File Number


I, Randy Kolehouse, in a field survey on February 3 19 98, do hereby certify that under requirements of P.A. 74 Michigan P.A. of 1970, the corner points mentioned in lines 1 and 2 above were in conformance with regulations and rules therefore as required in the current manual of survey instructions of the United States Department of the interior, Bureau of Land Management or by a decree of a Court of Law and/or that the corner points mentioned in lines 3, 4 and 5 above were in conformance with the rules of the Michigan Board of Land Surveyors or by a Decree of a Court of Law; established, re-established, monumented, re-monumented, recovered, found as expressed below:

NOTE: Not more than 4 corners, all in the same town and range, may be recorded on this certificate.

A. Description of original monument and accessories and/or subsequent restoration:

B-7	1837	G.L.O. Notes	Cathcart	Set Post
	1943	Witness Map	K.C. Surveyor	1" Iron
	1972	L.C.R.C. #253	Williams & Works	1" Iron
	1974	L.C.R.C. #758	G. Fauser	"T" Iron - Capped
	1981	L.C.R.C. #1870	Jonker Land Survey	Fnd. Capped "T" Iron / Set K.C. Monument
	1994	L.C.R.C. #7978	Glaza & Associates	K.C. Monument

P.A. 345 1990 KENT COUNTY
PEER APPROVED 6/29/98
CHAIRMAN Randy Kolehouse

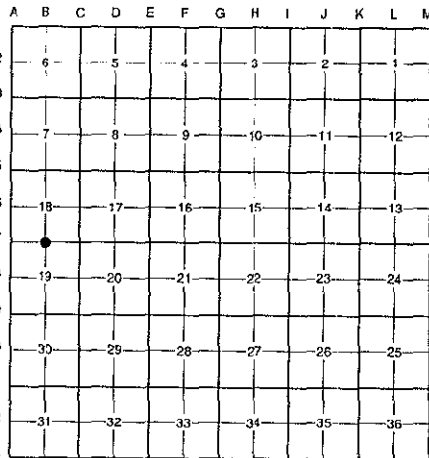

This corner was originally approved by the Kent County Remonumentation Peer Group and monumented by Rob Jonker on 6/2/81 and was recorded per L.C.R.C. #1870.

B. Description of corner evidence found and/or method applied in restoring or reestablishing corner:

B-7 Found a Standard Kent County Monument 66' ± Northwest of the C/L of 7 Mile Road (gravel) running East and South, 30' ± South of a fence line running East and West, and 45' East of a fence line running North and South per L.C.R.C.'s #1870 and #7978 as set by Rob Jonker in place of a capped "T" iron he found which checked L.C.R.C.'s #758, #253 and the K.C. Surveyor's records.

L.C.R.C. #1870

L.C.R.C. #7978

Remon. tag on S. side 18" dbl. oak N85°E 68.65'
C.L. gravel SE 66' +/-

K.C. remon tag & nail in S side 12" Oak N60°W 41.54' (41.53')
K.C. remon tag & nail in S side 22" Oak N80°E 67.96'
K.C. remon tag & nail in W side 12" Dbl. Oak S55°W 34.22' (m. 34.23')
K.C. remon tag & nail in SE side 8" Maple N40°E 20.22'
C/L gravel SE 66' +/-

The selected location is accepted by me and is generally accepted by professional surveyors as the best available evidence of the position of the original corner.

C. Description of monument for corner and accessories established to perpetuate locating the position of the corner:

C-7 Standard Kent County Monument

- Nail & K.C. remon. tag on S side 12" Oak N 60° W 41.53'
- Nail & K.C. remon. tag on S side 22" Oak N 80° E 67.96'
- Nail & K.C. remon. tag on N side 12" Double Oak S 55° W 34.23'
- Nail & K.C. remon. tag on SE side 8" Maple N 40° E 20.22'
- C/L gravel road running E & S, Southeast 66' ±
- Fence line running E-W, North 30'
- Fence line running N-S, West 45'

signed by

Randy J. Kolehouse
EARTH TECH

Date

9-1-98

Surveyor's Michigan License No. 25854

