

OCT 28 1994

LAND CORNER RECORDATION CERTIFICATE
Filing Requirement of Act 74, Mich. P.A. 1970

STATE OF MICHIGAN
COUNTY OF KENT
RECEIVED FOR RECORD

94 AUG 24 AM 11:52

For corners in COMMISSION

Kent Located In: Grattan twp. Corner Code B-8
(County)

1. Public Land Survey T 8N R 9W Center Sec. 19
T ___ R ___
T ___ R ___
T ___ R ___

2. Property Controlling S ___ T ___ R ___
in Section S ___ T ___ R ___

3. Miscellaneous S ___ T ___ R ___
Property in Sec. S ___ T ___ R ___

Lucy Bond
REG. OF DEEDS

6975

Register of Deeds Stamp & File Number

4. Lot No. _____, Recorded Plat _____
5. Private Claims _____

| | A | B | C | D | E | F | G | H | I | J | K | L | M |
|----|----|---|----|---|----|---|----|---|----|---|----|---|----|
| 2 | 6 | | 5 | | 4 | | 3 | | 2 | | 1 | | |
| 3 | | | | | | | | | | | | | |
| 4 | 7 | | 8 | | 9 | | 10 | | 11 | | 12 | | |
| 5 | | | | | | | | | | | | | |
| 6 | 18 | | 17 | | 16 | | 15 | | 14 | | 13 | | |
| 7 | | | | | | | | | | | | | |
| 8 | | | | ▲ | 20 | | 21 | | 22 | | 23 | | 24 |
| 9 | | | | | | | | | | | | | |
| 10 | 30 | | 29 | | 28 | | 27 | | 26 | | 25 | | |
| 11 | | | | | | | | | | | | | |
| 12 | 31 | | 32 | | 33 | | 34 | | 35 | | 36 | | |
| 13 | | | | | | | | | | | | | |

I, Wallace E. Glaza in a field survey on August 2, 1994, do hereby certify that under requirements of P.A. 74, Michigan P.A. of 1970, the corner points mentioned in lines 1 and 2 above were in conformance with regulations and rules therefore as required in the current manual of survey instructions of the United States Department of the Interior, Bureau of Land Management or by a decree of a Court of Law and/or that the corner points mentioned in lines 3, 4 and 5 above were in conformance with the rules of the Michigan Board of Land Surveyors or by a Decree of a Court of Law; established, re-established, monumented, re-monumented, recovered, found as expressed below:

NOTE: Not more than 4 corners, all in the same town and range, may be recorded on this certificate.

A. Description of original monument and accessories and/or subsequent restoration:


L.C.R.C. No. 5781
Set capped iron at intersection of 1/4 lines
S60°W 39.75' Remon tag NE side 36" Maple
N30°E 1.01' Remon tag N. side 8" twin Maple
N30°W 30.71' Remon tag SW side 10" Maple
Due West 28.82' Remon tag S. side 8" twin Maple
Iron is 1' South of a barbed wire fence & falls between a double Maple.
Iron driven through the roots.

B. Description of corner evidence found and/or method applied in restoring or reestablishing corner:

B-8 (Center of Section 19, T8N, R9W, Grattan Township, Kent County, Michigan)
Found capped iron and verified it to be at the intersection of the 1/4 lines.
Replaced capped iron with standard 4" x 30" Kent County monument. (Harrison)

West 1/4 corner to Center - 2613.58'
North 1/4 corner to Center - 2646.24'
East 1/4 corner to Center - 2641.99'
South 1/4 corner to Center - 2638.68'

P.A. 345 1930 KENT COUNTY
PEER APPROVED 7/28/94
CHAIRMAN *Harry Huber*

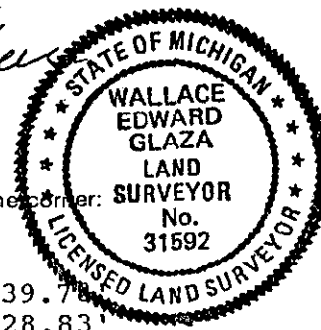

C. Description of monument for corner and accessories established to perpetuate locating the position of the corner:

B-8 (4" x 30" Kent County monument)
1) Found Remon tag & nail in NE'ly side 24" Maple S25°E 39.75'
2) Found Remon tag & nail in S'ly side 8" twin Maple N90°E 28.83'
3) Found Remon tag & nail in W'ly side 10" Maple N20°W 30.75'
4) Found Remon tag & nail in N. side 8" Maple N90°E 1.05'
5) Remnants of fence lines to North & East on line ±.

Signed by Wallace E. Glaza
Glaza and Associates, Inc.
Surveyor's Michigan License No. 31592

Date August 4, 1994