

SURVEY & REMONUMENTATION

MAR 08 1999

LAND CORNER RECORDATION CERTIFICATE
Filing Requirement of Act 74, Mich. P.A. 1970
KENT COUNTY REMONUMENTATION

For corners in

SECTION

| Kent (County) | Located in: | Grattan Township | Corner Code # |
|---------------------------------------|-------------|---------------------|---------------|
| 1. Public Land Survey | T <u>8N</u> | R <u>9W</u> | <u>B-9</u> |
| | T _____ | R _____ | _____ |
| | T _____ | R _____ | _____ |
| | T _____ | R _____ | _____ |
| 2. Property Controlling in Section | S _____ | T _____ | R _____ |
| | S _____ | T _____ | R _____ |
| 3. Miscellaneous Property in Sec. | S _____ | T _____ | R _____ |
| | S _____ | T _____ | R _____ |

4. Lot No. _____, Recorded Plat _____
 5. Private Claims _____

STATE OF MICHIGAN
 COUNTY OF KENT
 RECEIVED FOR RECORD
 98 OCT 23 AM 9:58
 REG. OF DEEDS
David J. Fisher


10828
 Register of Deeds Stamp & File Number

I, Randy Kolehouse, in a field survey on February 2 19 98, do hereby certify that under requirements of P.A. 74 Michigan P.A. of 1970, the corner points mentioned in lines 1 and 2 above were in conformance with regulations and rules therefore as required in the current manual of survey instructions of the United States Department of the interior, Bureau of Land Management or by a decree of a Court of Law and/or that the corner points mentioned in lines 3, 4 and 5 above were in conformance with the rules of the Michigan Board of Land Surveyors or by a Decree of a Court of Law; established, re-established, monumented, re-monumented, recovered, found as expressed below:

NOTE: Not more than 4 corners, all in the same town and range, may be recorded on this certificate.

A. Description of original monument and accessories and/or subsequent restoration:

| | | | | |
|-----|------|----------------|--------------------|------------------------------------|
| B-9 | 1837 | G.L.O. Notes | Cathcart | Set Post |
| | 1934 | Witness Map | K.C. Surveyor | Iron |
| | 1980 | L.C.R.C. #1403 | Williams & Works | 3/4" Iron in Concrete |
| | 1981 | L.C.R.C. #1857 | Jonker Land Survey | Fnd. 3/4" Iron / Set K.C. Monument |
| | 1994 | L.C.R.C. #7979 | Glaza & Associates | K.C. Monument |

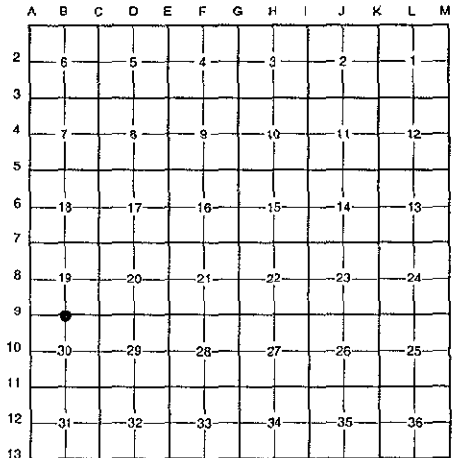

P.A. 345 1990 KENT COUNTY
PEER APPROVED 6/25/98
CHAIRMAN *Harry Fisher*

This corner was originally approved by the Kent County Remonumentation Peer Group and monumented by Rob Jonker on 6/1/81 and was recorded per L.C.R.C. #1857.

B. Description of corner evidence found and/or method applied in restoring or reestablishing corner:


B-9 Found a Standard Kent County Monument on the C/L of 6 Mile Road (gravel) running East and West, on line of a tree row running North and South, per L.C.R.C.'s #1857 and #7979 as set by Rob Jonker in place of a 3/4" iron he found in a plat monument which checked L.C.R.C. #1403 and the K.C. Surveyor's records.

| L.C.R.C. #1857 | L.C.R.C. #7979 |
|---|---|
| Top NW Cor. pillar S. 33.38' | Top NW corner of pillar South 33.36' (m. 33.35') |
| Remon. tag on SW side 32" oak S45°E 46.53' | K.C. remon tag & nail in SW side 32" Oak S45°E 46.54' (m. 46.57') |
| Remon. tag on W. side 10" Cherry N20°W 38.79' | K.C. remon tag & nail in W side 12" Cherry N20°W 38.78' (m. 38.74') |
| Remon. tag on S. side dbl. 10" oak N65°E 44.04' | K.C. remon tag & nail in S side 14" Dbl. Oak N65°E 44.00' (m. 43.99') |
| | On C/L East-West gravel |

The selected location is accepted by me and is generally accepted by professional surveyors as the best available evidence of the position of the original corner.

C. Description of monument for corner and accessories established to perpetuate locating the position of the corner:

- B-9 Standard Kent County Monument
- Top NW cor. to stone pillar South 33.35'
 - Nail & K.C. remon. tag on SW side 32" Oak S 45° E 46.57'
 - Nail & K.C. remon. tag on W side 12" Cherry N 20° W 38.74'
 - Nail & K.C. remon. tag on S side 14" double Oak N 65° E 43.99'
 - On C/L of gravel road running E-W
 - On tree row running N-S

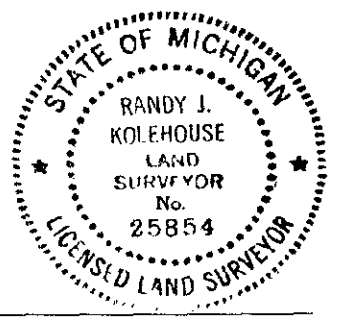

Signed by *Randy J. Kolehouse*
 EARTH TECH

Date 9-1-98

Surveyor's Michigan License No. 25854