

SURVEY & REMONUMENTATION

\$7.00
\$2.00

MAR 08 1999

LAND CORNER RECORDATION CERTIFICATE
Filing Requirement of Act 74, Mich. P.A. 1970
KENT COUNTY REMONUMENTATION

SECTION

For corners in

Kent (County)	Located in:	Grattan Township	Corner Code #
1. Public Land Survey	T <u>8N</u>	R <u>9W</u>	<u>B-10</u>
	T _____	R _____	_____
	T _____	R _____	_____
	T _____	R _____	_____
2. Property Controlling in Section	S _____	T _____	R _____
	S _____	T _____	R _____
3. Miscellaneous Property in Sec.	S _____	T _____	R _____
	S _____	T _____	R _____


STATE OF MICHIGAN
COUNTY OF KENT
RECEIVED FOR RECORD
98 DEC 14 AM 8:00
REG. OF DEEDS
Tim Stand

11042

Register of Deeds Stamp & File Number

- 4. Lot No. _____, Recorded Plat _____
- 5. Private Claims _____

I, Randy Kolehouse, in a field survey on October 30 19 98, do hereby certify that under requirements of P.A. 74 Michigan P.A. of 1970, the corner points mentioned in lines 1 and 2 above were in conformance with regulations and rules therefore as required in the current manual of survey instructions of the United States Department of the interior, Bureau of Land Management or by a decree of a Court of Law and/or that the corner points mentioned in lines 3, 4 and 5 above were in conformance with the rules of the Michigan Board of Land Surveyors or by a Decree of a Court of Law; established, re-established, monumented, re-monumented, recovered, found as expressed below:

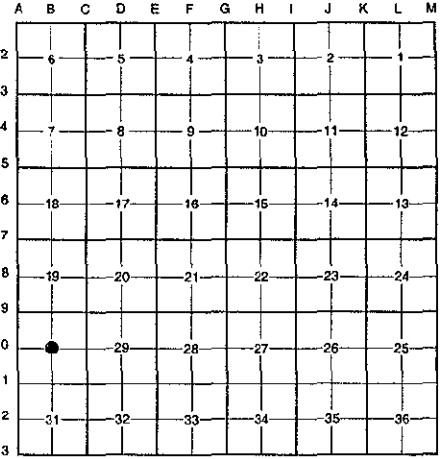

NOTE: Not more than 4 corners, all in the same town and range, may be recorded on this certificate.

A. Description of original monument and accessories and/or subsequent restoration:

B-10 This corner was not originally set by the G.L.O.
No information was available on this corner.

P.A. 345 1990 KENT COUNTY
PEER APPROVED 11/12/98
CHAIRMAN *Harry Huber*

B. Description of corner evidence found and/or method applied in restoring or reestablishing corner:

B-10 Set a monument at the intersection of 1/4 lines. Monument is 1' South of a tree row running East and West, 75' ± South of a grass runway running East and West and 200' ± West of a grass runway running North.

The selected location is accepted by me and is generally accepted by professional surveyors as the best available evidence of the position of the original corner.

C. Description of monument for corner and accessories established to perpetuate locating the position of the corner:

- B-10 Set a Standard Kent County Monument
- Nail & K.C. remon. tag on E side 10" Cherry N 05° W 24.90'
- Nail & K.C. remon. tag on SE side 30" Twin Oak N 60° E 28.30'
- Nail & K.C. remon. tag on NE side 9" Sassafras N 40° W 19.66'
- Nail & K.C. remon. tag on S side 10" Cherry N 70° W 34.65'
- Tree row running E-W, North 1'
- Grass runway running E-W, North 75' ±
- Grass runway running N, East 200' ±



Signed by *Randy J. Kolehouse*
EARTH TECH

Date 12/5/98

Surveyor's Michigan License No. 25854