

\$7.00
\$2.00

MAR 08 1999

LAND CORNER RECORDATION CERTIFICATE
Filing Requirement of Act 74, Mich. P.A. 1970
KENT COUNTY REMONUMENTATION

STATE OF MICHIGAN
COUNTY OF KENT
RECEIVED FOR RECORD
98 OCT 23 AM 9:58
REG. OF DEEDS
Lucy St. Paul

SECTION

For corners in

| Kent (County) | Located in: | Grattan Township | Corner Code # |
|---------------------------------------|-------------|---------------------|---------------|
| 1. Public Land Survey | T <u>8N</u> | R <u>9W</u> | <u>B-11</u> |
| | T _____ | R _____ | _____ |
| | T _____ | R _____ | _____ |
| | T _____ | R _____ | _____ |
| 2. Property Controlling in Section | S _____ | T _____ | R _____ |
| | S _____ | T _____ | R _____ |
| 3. Miscellaneous Property in Sec. | S _____ | T _____ | R _____ |
| | S _____ | T _____ | R _____ |

10829

Register of Deeds Stamp & File Number


- 4. Lot No. _____, Recorded Plat _____
- 5. Private Claims _____

I, Randy Kolehouse, in a field survey on January 26 19 98, do hereby certify that under requirements of P.A. 74 Michigan P.A. of 1970, the corner points mentioned in lines 1 and 2 above were in conformance with regulations and rules therefore as required in the current manual of survey instructions of the United States Department of the Interior, Bureau of Land Management or by a decree of a Court of Law and/or that the corner points mentioned in lines 3, 4 and 5 above were in conformance with the rules of the Michigan Board of Land Surveyors or by a Decree of a Court of Law; established, re-established, monumented, re-monumented, recovered, found as expressed below:

NOTE: Not more than 4 corners, all in the same town and range, may be recorded on this certificate.

A. Description of original monument and accessories and/or subsequent restoration:

| | | | | |
|------|------|----------------|----------------------|--|
| B-11 | 1837 | G.L.O. Notes | Cathcart | Set Post |
| | N/A | Witness Map | K.C. Surveyor | Concrete Monument |
| | 1974 | L.C.R.C. #710 | Williams & Works | 3/4" Iron in Monument Box |
| | 1981 | L.C.R.C. #1868 | Jonker Land Survey | Fnd. 3/4" Iron in Monument Box / Set K.C. Monument in Mon. Box |
| | 1982 | L.C.R.C. #3098 | All-Points Surveyors | Reset K.C. Monument in Monument Box |
| | 1994 | L.C.R.C. #7980 | Glaza & Associates | Replaced Broken K.C. Monument |

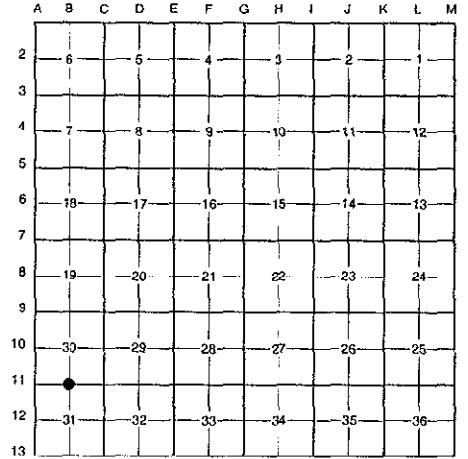

This corner was originally approved by the Kent County Remonumentation Peer Group and monumented by Rob Jonker on 6/1/81 and was recorded per L.C.R.C. #1868.

B. Description of corner evidence found and/or method applied in restoring or reestablishing corner:

B-11 Found a Standard Kent County Monument in a monument box on the C/L of 5 Mile Road (bit.) running East and West, on line of a tree row running South and a Pine tree row running North, per L.C.R.C.'s #3098 and #7980 as set by Rob Jonker in place of a 3/4" iron he found inside of a plat monument in a monument box which checked L.C.R.C.'s #1868, #710 and the K.C. Surveyor's records.

L.C.R.C. #3098

S5°W to chiseled cross on W. end of 12" conc. drive culvert
N42°E to chiseled cross on E. end of 12" conc. drive culvert

L.C.R.C. #7980

"X" cut on E end of concrete culvert N45°E 38.62'
"X" cut in W end of concrete culvert S00°W 32.88' (m. 32.88')
K.C. remon tag & nail in W side fence post S06°E 50.05' (m. 50.04')
K.C. remon tag & nail in E side fence post N11°W 52.87' (m. 52.92')

The selected location is accepted by me and is generally accepted by professional surveyors as the best available evidence of the position of the original corner.

C. Description of monument for corner and accessories established to perpetuate locating the position of the corner:

C-11 Standard Kent County Monument in a Monument Box

- Nail & K.C. remon. tag on W side fence post S 06° E 50.04'
- Nail & K.C. remon. tag on E side fence post N 11° W 52.92'
- "X" cut on E end conc. culvert N 45° E 38.62'
- "X" cut on W end conc. culvert S 00° W 32.88'
- On C/L of bit. road running E-W
- On tree row running South
- On tree row running North

P.A. 345 1990 KENT COUNTY
PEER APPROVED 6/29/98
CHAIRMAN [Signature]



igned by Randy J. Kolehouse Date 9-1-98
EARTH TECH

urveyor's Michigan License No. 25854