

MAR 08 1999

\$7.00  
\$2.00

SECTION

LAND CORNER RECORDATION CERTIFICATE  
Filing Requirement of Act 74, Mich. P.A. 1970  
KENT COUNTY REMONUMENTATION

STATE OF MICHIGAN  
COUNTY OF KENT  
RECEIVED FOR RECORD  
98 DEC 14 AM 8:00  
REG. OF DEEDS  
*Lucy Stand*

For corners in


Kent (County)	Located in: Grattan Township	Corner Code #
1. Public Land Survey	T <u>8N</u> R <u>9W</u>	<u>B-13</u>
	T _____ R _____	_____
	T _____ R _____	_____
	T _____ R _____	_____
2. Property Controlling in Section	S _____ T _____ R _____	_____
	S _____ T _____ R _____	_____
3. Miscellaneous Property in Sec.	S _____ T _____ R _____	_____
	S _____ T _____ R _____	_____

10965  
Register of Deeds Stamp & File Number

4. Lot No. \_\_\_\_\_, Recorded Plat \_\_\_\_\_  
5. Private Claims \_\_\_\_\_

I, Randy Kolehouse, in a field survey on December 31 19 97, do hereby certify that under requirements of P.A. 74 Michigan P.A. of 1970, the corner points mentioned in lines 1 and 2 above were in conformance with regulations and rules therefore as required in the current manual of survey instructions of the United States Department of the interior, Bureau of Land Management or by a decree of a Court of Law and/or that the corner points mentioned in lines 3, 4 and 5 above were in conformance with the rules of the Michigan Board of Land Surveyors or by a Decree of a Court of Law: established, re-established, monumented, re-monumented, recovered, found as expressed below:

NOTE: Not more than 4 corners, all in the same town and range, may be recorded on this certificate.

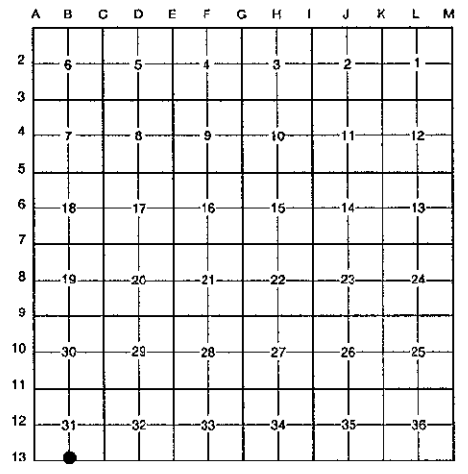

A. Description of original monument and accessories and/or subsequent restoration:

B-13	1837	G.L.O. Notes	N. Brookfield	Set Post
	1977	L.C.R.C. #1090	Medema, Van Kooten & Assoc.	Set "L" Iron
	1982	L.C.R.C. #3114	Williams & Works	"L" Iron
	1994	L.C.R.C. #7982	Glaza & Associates	"L" Iron

P.A. 345 1990 KENT COUNTY  
PEER APPROVED 9/24/98  
CHAIRMAN [Signature]

This corner was originally approved by the Kent County Remonumentation Peer Group and set by Williams & Works on 10/13/82 and was recorded per L.C.R.C. #3114.

Note: This corner is not common with B-1, T7N, R9W.

B. Description of corner evidence found and/or method applied in restoring or reestablishing corner:

B-13 Found an "L" iron in a tree root on line of a tree row running North, East and West, 115.50' West of a Kent County monument at B-1, T9N, R9W, per L.C.R.C.'s #1090, #3114 and #7982.


L.C.R.C. #7982

- Nail & K.C. remon tag in E side 15" Oak N 20° E 31.12'
- Nail & K.C. remon tag in E side 22" Ash North 44.93' (m. 44.96')
- Nail & K.C. remon tag in W side 30" Maple (stump) East 0.36'
- Corner iron is at corner of fences E, W & N
- K.C. mon at N 1/4 cor, Sec 6, T7N, R9W N 90°E 131.50' (m. 115.50')

The selected location is accepted by me and is generally accepted by professional surveyors as the best available evidence of the position of the original corner.

C. Description of monument for corner and accessories established to perpetuate locating the position of the corner:

- B-13 "L" Iron in Tree Root
- Nail & K.C. remon. tag on E face 15" Oak N 20° E 31.12'
  - Nail & K.C. remon. tag on E face 22" Ash North 44.96'
  - Nail & K.C. remon. tag on W face 40" Maple stump East 0.36'
  - Nail & K.C. remon. tag on N face 6" Maple S 85° W 16.80'
  - On tree row running N-E-W
  - K.C. Mon., B-1, T7N, R9W, East 115.50'

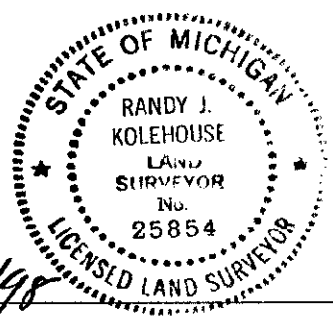

Signed by Randy J. Kolehouse  
EARTH TECH

Date 11/18/98

Surveyor's Michigan License No. 25854