

\$7.00
\$2.00

SURVEYOR'S
REMONUMENTATION

REC 08 1998

LAND CORNER RECORDATION CERTIFICATE Filing Requirement of Act 74, Mich. P.A. 1970 KENT COUNTY REMONUMENTATION

STATE OF MICHIGAN
COUNTY OF KENT
RECEIVED FOR RECORD
98 OCT 23 AM 9:58
REG. OF DEEDS
Lucy St. Paul

For corners in

SECTION


Kent (County)	Located in:	Grattan Township	Corner Code #
1. Public Land Survey	T <u>8N</u>	R <u>9W</u>	<u>C-4</u>
	T _____	R _____	_____
	T _____	R _____	_____
	T _____	R _____	_____
2. Property Controlling in Section	S _____	T _____	R _____
	S _____	T _____	R _____
3. Miscellaneous Property in Sec.	S _____	T _____	R _____
	S _____	T _____	R _____

10832
Register of Deeds Stamp & File Number

- 4. Lot No. _____, Recorded Plat _____
- 5. Private Claims _____

I, Randy Kolehouse, in a field survey on February 5 19 98, do hereby certify that under requirements of P.A. 74 Michigan P.A. of 1970, the corner points mentioned in lines 1 and 2 above were in conformance with regulations and rules therefore as required in the current manual of survey instructions of the United States Department of the interior, Bureau of Land Management or by a decree of a Court of Law and/or that the corner points mentioned in lines 3, 4 and 5 above were in conformance with the rules of the Michigan Board of Land Surveyors or by a Decree of a Court of Law; established, re-established, monumented, re-monumented, recovered, found as expressed below:

NOTE: Not more than 4 corners, all in the same town and range, may be recorded on this certificate.

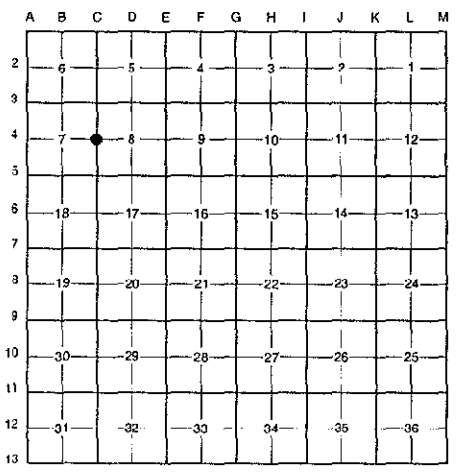

A. Description of original monument and accessories and/or subsequent restoration:

C-4	1837	G.L.O. Notes	Cathcart	Set Post
	1941	Witness Map	K.C. Surveyor	3/4" Iron
	1978	L.C.R.C. #1177	Medema, Van Kooten & Assoc.	3/4" Iron
	1984	L.C.R.C. #4220	R. Kolehouse	Fnd. 3/4" Iron / Set K.C. Monument
	1994	L.C.R.C. #7986	Glaza & Associates	K.C. Monument

P.A. 345 1990 KENT COUNTY
PEER APPROVED 6/29/98
CHAIRMAN [Signature]

This corner was originally approved by the Kent County Remonumentation Peer Group and monumented by Randy Kolehouse on 5/11/85 and was recorded per L.C.R.C. #4220.

B. Description of corner evidence found and/or method applied in restoring or reestablishing corner:

C-4 Found a Standard Kent County Monument 4.0' South and 11.0' West of the C/L "X" of Whitten Road (gravel) running East and West and Nutent Avenue (gravel) running North per L.C.R.C.'s #4220 and #7986 as set by Randy Kolehouse in place of a 3/4" iron he found which checked L.C.R.C. #1177 and the K.C. Surveyor's records.

L.C.R.C. #4220

L.C.R.C. #7986

- Nail & K.C. Remon. tag in W. side 26" Oak N 10° W 68.65'
- Nail & K.C. Remon. tag in W. side 26" Oak N 25° E 82.98'
- Nail & K.C. Remon. tag in E. side 4" Oak N 45° W 61.73'
- Nail & K.C. Remon. tag in W. side 8" Poplar S 10° W 15.90'
- Nail & K.C. Remon. tag in E. side twin 12" W. Cherry S 20° E 20.20'


- Nail & K.C. remon tag in W side 36" Oak N10°W 68.65' (m. 68.64')
- Nail & K.C. remon tag in W side 36" Oak N25°E 82.98' (m. 82.94')
- Nail & K.C. remon tag E side 8" Oak N45°W 61.62' (m. 61.63')
- Nail & K.C. remon tag in W side 10" Poplar S10°W 15.75'
- Nail & K.C. remon tag in E side 12" Twin W. Cherry S20°E 20.17' (m. 20.13')

The selected location is accepted by me and is generally accepted by professional surveyors as the best available evidence of the position of the original corner.

C. Description of monument for corner and accessories established to perpetuate locating the position of the corner:

C-4 Standard Kent County Monument

- Nail & K.C. remon. tag on W side 36" Oak N 10° W 68.64'
- Nail & K.C. remon. tag on W side 36" Oak N 25° E 82.94'
- Nail & K.C. remon. tag on E side twin 8" Oak N 45° W 61.63'
- Nail & K.C. remon. tag on W side 10" Poplar S 10° W 15.75'
- Nail & K.C. remon. tag on E side 12" twin W. Cherry S 20° E 20.13'
- C/L "X" of gravel roads running E-W-N is North 4.0' and East 11.0'

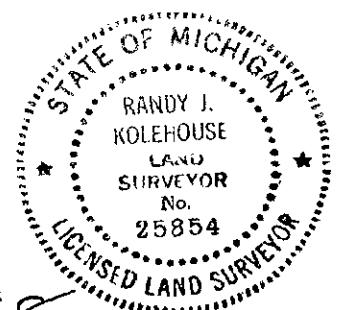

Signed by Randy J. Kolehouse Date 9-1-98
EARTH TECH

Surveyor's Michigan License No. 25854