

\$7.00
\$2.00

SURVEY &
REMONUMENTATION

SEP 8 1998 LAND CORNER RECORDATION CERTIFICATE
Filing Requirement of Act 74, Mich. P.A. 1970
KENT COUNTY REMONUMENTATION

STATE OF MICHIGAN
COUNTY OF KENT
RECEIVED FOR RECORD
38 OCT 23 AM 9:58

REG. OF DEEDS

Lucy Stand

10833

Register of Deeds Stamp & File Number


For corners in	SECTION	Located in:	Grattan Township	Corner Code #
Kent (County)				
1. Public Land Survey	T 8N R 9W			C-5
	T R			
	T R			
	T R			
2. Property Controlling in Section	S T R			
	S T R			
3. Miscellaneous Property in Sec.	S T R			
	S T R			

4. Lot No. _____, Recorded Plat _____
5. Private Claims _____

I, Randy Kolehouse, in a field survey on March 2 19 98, do hereby certify that under requirements of P.A. 74 Michigan P.A. of 1970, the corner points mentioned in lines 1 and 2 above were in conformance with regulations and rules therefore as required in the current manual of survey instructions of the United States Department of the interior, Bureau of Land Management or by a decree of a Court of Law and/or that the corner points mentioned in lines 3, 4 and 5 above were in conformance with the rules of the Michigan Board of Land Surveyors or by a Decree of a Court of Law; established, re-established, monumented, re-monumented, recovered, found as expressed below:

NOTE: Not more than 4 corners, all in the same town and range, may be recorded on this certificate.

A.	Description of original monument and accessories and/or subsequent restoration:
C-5	1837 G.L.O. Notes Cathcart Set Post
	1965 Witness Map K.C. Surveyor 1" Iron
	1974 L.C.R.C. #758 G. Fauser 1-1/2" Angle Iron
	1981 L.C.R.C. #1869 Jonker Land Survey Fnd. 1" Rd. Iron / Set K.C. Monument
	1994 L.C.R.C. #7987 Glaza & Associates K.C. Monument

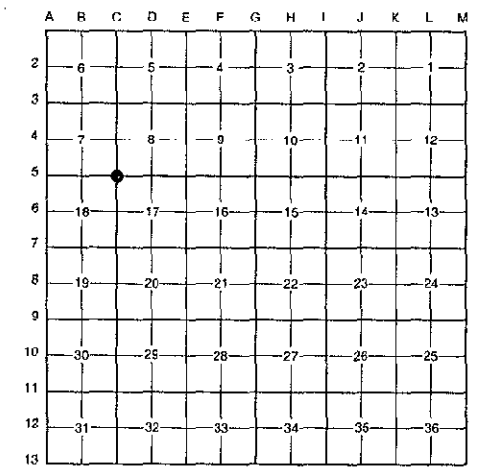

P.A. #345 1990 KENT COUNTY
PEER APPROVED 6/25/98
CHAIRMAN *[Signature]*

This corner was originally approved by the Kent County Remonumentation Peer Group and monumented by Rob Jonker on 6/2/81 and was recorded per L.C.R.C. #1869.


Description of corner evidence found and/or method applied in restoring or reestablishing corner:
-5 Found a Standard Kent County Monument 69' ± Northwest of the C/L of Nugent Avenue (gravel) running Northeastly. Monument falls in the swamp 4.0' from the East edge. Checks L.C.R.C.'s #1869 and #7987 as set by Rob Jonker in place of a 1" rd. pinched iron he found which also checked L.C.R.C. #758 and the K.C. Surveyor's records.

L.C.R.C. #1869	L.C.R.C. #7987
Remon. tag on NE side 20" oak S40°E 33.90'	K.C. remon tag & nail in NE side 20" Oak S40°E 33.74' (m. 33.78')
Remon. tag on E side 8" hickory S0°E 56.90'	K.C. remon tag & nail in E side 12" Hickory S00°E 56.75' (m. 56.90')
Remon. tag on N. side 12" maple clump S40°W 57.70'	K.C. remon tag & nail in N side 12" Maple S40°W 57.80' (m. 57.79')
Remon. tag on N. side 24" oak N90°E 56.26'	K.C. remon tag & nail in N side 24" Oak N90°E 55.83' (m. 55.78')
C.L. angle iron N80°E 0.5'	C/L angle iron N80°E 0.5' (m. 0.45')
C.L. gravel road SE 72' +/-	

The selected location is accepted by me and is generally accepted by professional surveyors as the best available evidence of the position of the original corner.

Description of monument for corner and accessories established to perpetuate locating the position of the corner:

- 5 Standard Kent County Monument
- Nail & K.C. remon. tag on NE side 20" Oak S 40° E 33.78'
- Nail & K.C. remon. tag on E side 12" Hickory S 00° E 56.90'
- Nail & K.C. remon. tag on N side 12" Maple S 40° W 57.79'
- Nail & K.C. remon. tag on N side 24" Oak N 90° E 55.78'
- C/L angle iron N 80° E 0.45'
- C/L of gravel road running NE'ly, Southeast 69' ±

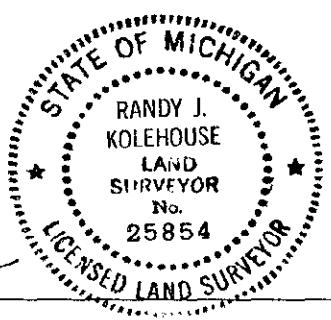

Signed by *Randy J. Kolehouse* Date 9-1-98

Surveyor's Michigan License No. 25854