

\$7.00  
\$2.00

MAR 08 1999

**LAND CORNER RECORDATION CERTIFICATE**  
Filing Requirement of Act 74, Mich. P.A. 1970  
KENT COUNTY REMONUMENTATION

For corners in SECTION


Kent (County)	Located in: Gratiot Township	Corner Code #
1. Public Land Survey	T <u>8N</u> R <u>9W</u>	<u>C-6</u>
	T _____ R _____	_____
	T _____ R _____	_____
	T _____ R _____	_____
2. Property Controlling in Section	S _____ T _____ R _____	_____
	S _____ T _____ R _____	_____
3. Miscellaneous Property in Sec.	S _____ T _____ R _____	_____
	S _____ T _____ R _____	_____
4. Lot No. _____, Recorded Plat _____		
5. Private Claims _____		

STATE OF MICHIGAN  
COUNTY OF KENT  
RECEIVED FOR RECORD  
98 OCT 23 AM 9:58  
REG. OF DEEDS  
*[Signature]*

10834

Register of Deeds Stamp & File Number

I, Randy Kolehouse, in a field survey on March 30 19 98, do hereby certify that under requirements of P.A. 74 Michigan P.A. of 1970, the corner points mentioned in lines 1 and 2 above were in conformance with regulations and rules therefore as required in the current manual of survey instructions of the United States Department of the Interior, Bureau of Land Management or by a decree of a Court of Law and/or that the corner points mentioned in lines 3, 4 and 5 above were in conformance with the rules of the Michigan Board of Land Surveyors or by a Decree of a Court of Law; established, re-established, monumented, re-monumented, recovered, found as expressed below:

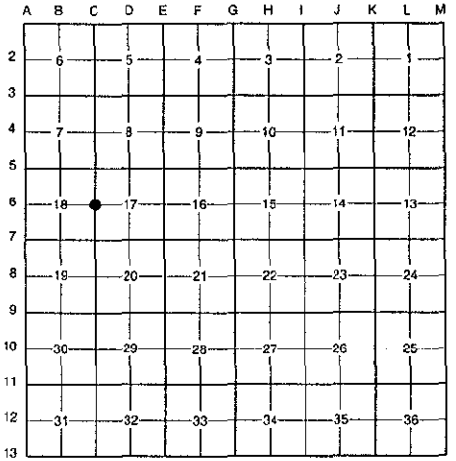

**NOTE: Not more than 4 corners, all in the same town and range, may be recorded on this certificate.**

**A. Description of original monument and accessories and/or subsequent restoration:**

C-6	1837	G.L.O. Notes	Cathcart	4" Tamarack
	1954	Notes	Williams & Works	Set Iron
	N/A	Witness Map	K.C. Surveyor	1" Iron
	1985	L.C.R.C. #4297	Randy Kolehouse	Fnd. 3/4" Iron / Set K.C. Monument
	1994	L.C.R.C. #7988	Glaza & Associates	K.C. Monument

P.A. 345 1990 KENT COUNTY  
PEER APPROVED 6/25/98  
CHAIRMAN [Signature]

This corner was originally approved by the Kent County Remonumentation Peer Group and monumented by Randy Kolehouse on 8/6/85 and was recorded per L.C.R.C. #4297.

**B. Description of corner evidence found and/or method applied in restoring or reestablishing corner:**

C-6 Found a Standard Kent County Monument in the swamp 1.0' under water, on line of old fence line running North and South, per L.C.R.C.'s #4297 and #7988 as set by Randy Kolehouse in place of a 3/4" iron he found which checked the 1954 notes of Williams & Works and the K.C. Surveyor's records.

**L.C.R.C. #4297**

**L.C.R.C. #7988**

- Nail & K.C. Remon. tag in N. side tw 12" Oak East 9.00'
- Nail & K.C. Remon. tag in NW side tw 12" Maple N 45° E 13.35'
- Nail & K.C. Remon. tag in E. side 6" Maple South 1.80'
- Nail & K.C. Remon. tag in NE side 10" Maple S 65° E 17.42'
- N edge of pond South 50' m/l
- N edge of Swamp North 150' m/l


- Nail & K.C. remon tag in N side 14" Twin Oak East 9.07' (m. 9.09')
- Nail & K.C. remon tag in NW side 12" Twin Maple N45°E 13.28' (m. 13.27')
- Nail & K.C. remon tag in E side 6" Maple South 1.88' (m. 1.89')
- Nail & K.C. remon tag in NE side 10" Maple S65°E 17.38' (m. 17.39')
- North edge of pond South 30' m/l
- North edge of swamp North 175' m/l

The selected location is accepted by me and is generally accepted by professional surveyors as the best available evidence of the position of the original corner.

**C. Description of monument for corner and accessories established to perpetuate locating the position of the corner:**

**C-6 Standard Kent County Monument**

- Nail & K.C. remon. tag on N side 14" twin Oak East 9.09'
- Nail & K.C. remon. tag on NW side 12" twin Maple N 45° E 13.27'
- Nail & K.C. remon. tag on E side 6" Maple South 1.89'
- Nail & K.C. remon. tag on NE side 6" Maple S 65° E 17.39'
- On fence line running N-S

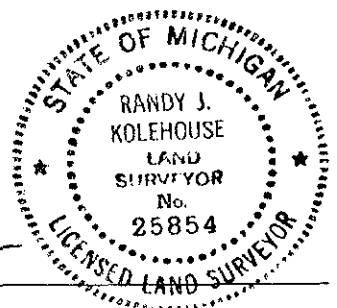

Signed by Randy J. Kolehouse Date 9-1-98

EARTH TECH

Surveyor's Michigan License No. 25854