

\$7.00
\$2.00

MAR 03 1999

SECTION

LAND CORNER RECORDATION CERTIFICATE
Filing Requirement of Act 74, Mich. P.A. 1970
KENT COUNTY REMONUMENTATION

For corners in

Kent (County)	Located in: Grattan Township	Corner Code #
1. Public Land Survey	T <u>8N</u> R <u>9W</u>	<u>C-7</u>
	T _____ R _____	_____
	T _____ R _____	_____
	T _____ R _____	_____
2. Property Controlling in Section	S _____ T _____ R _____	_____
	S _____ T _____ R _____	_____
3. Miscellaneous Property in Sec.	S _____ T _____ R _____	_____
	S _____ T _____ R _____	_____

STATE OF MICHIGAN
COUNTY OF KENT
RECEIVED FOR RECORD


98 OCT 23 AM 9:58

REG. OF DEEDS

Lucy Bond

10835
Register of Deeds Stamp & File Number

4. Lot No. _____, Recorded Plat _____
5. Private Claims _____

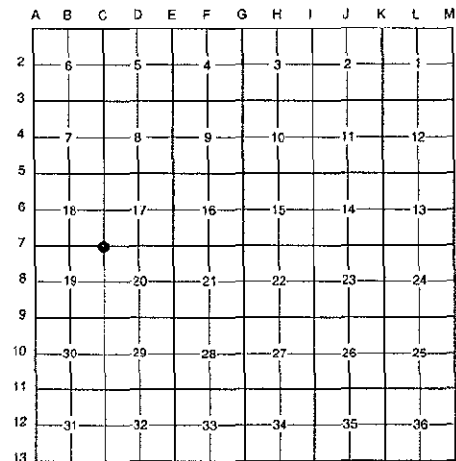

I, Randy Kolehouse, in a field survey on February 3 19 98, do hereby certify that under requirements of P.A. 74 Michigan P.A. of 1970, the corner points mentioned in lines 1 and 2 above were in conformance with regulations and rules therefore as required in the current manual of survey instructions of the United States Department of the interior, Bureau of Land Management or by a decree of a Court of Law and/or that the corner points mentioned in lines 3, 4 and 5 above were in conformance with the rules of the Michigan Board of Land Surveyors or by a Decree of a Court of Law; established, re-established, monumented, re-monumented, recovered, found as expressed below:

NOTE: Not more than 4 corners, all in the same town and range, may be recorded on this certificate.

A. Description of original monument and accessories and/or subsequent restoration:

C-7	1837	G.L.O. Notes	Cathcart	Set Post
	N/A	Witness Map	K.C. Surveyor	N/A
	1974	L.C.R.C. #758	G. Fauser	3/4" Iron Pipe
	1981	L.C.R.C. #1858	Jonker Land Survey	Fnd. 3/4" Iron / Set K.C. Monument
	1991	L.C.R.C. #5780	Prein & Newhof	K.C. Monument
	1994	L.C.R.C. #7989	Glaza & Associates	K.C. Monument

P.A. 345 1990 KENT COUNTY
PEER APPROVED *6/25/99*
CHAIRMAN *Rob Jonker*

This corner was originally approved by the Kent County Remonumentation Peer Group and monumented by Rob Jonker on 6/1/81 and was recorded per L.C.R.C. #1858.

B. Description of corner evidence found and/or method applied in restoring or reestablishing corner:

C-7 Found a Standard Kent County Monument on the C/L of 7 Mile Road (gravel) running East and West, on line of tree row running South, per L.C.R.C.'s #1858, #5780 and #7989 as set by Rob Jonker in place of a 3/4" iron he found over a 1/2" iron 12" below grade which checked L.C.R.C. #758 and the K.C. Surveyor's records.

L.C.R.C. #1858

L.C.R.C. #7989

Remon. tag on W. side 36" maple S01°W 23.97'
Remon. tg on E. side 40" maple S53°W 34.93'
Remon. tag on W. side 16" maple N27°E 39.65'
Remon. tag on N. side 10" Hickory S80°E 93.78'

K.C. remon tag & nail in W side 36" Maple S01°W 23.91' (m. 23.91')
K.C. remon tag & nail in E side 41" Maple S53°W 34.83' (m. 34.81')
K.C. remon tag & nail in W side 20" Maple N27°E 39.64'
K.C. remon tg & nail in N side 12" Hickory S80°E 93.82' (m. 93.81')

The selected location is accepted by me and is generally accepted by professional surveyors as the best available evidence of the position of the original corner.

C. Description of monument for corner and accessories established to perpetuate locating the position of the corner:

C-7 Standard Kent County Monument

- Nail & K.C. remon. tag on W side 36" Maple S 01° W 23.91'
- Nail & K.C. remon. tag on E side 41" Maple S 53° W 34.81'
- Nail & K.C. remon. tag on W side 20" Maple N 27° E 39.64'
- Nail & K.C. remon. tag on N side 12" Hickory S 80° E 93.81'
- On C/L of gravel road running E-W
- On tree row running S



Signed by *Randy J. Kolehouse* Date 9-1-98

EARTH TECH

Surveyor's Michigan License No. 25854