

SURVEY & REMONUMENTATION

\$7.00  
\$2.00

DEC 08 1998

LAND CORNER RECORDATION CERTIFICATE  
Filing Requirement of Act 74, Mich. P.A. 1970  
KENT COUNTY REMONUMENTATION

STATE OF MICHIGAN  
COUNTY OF KENT  
RECEIVED FOR RECORD  
98 OCT 23 AM 9:58  
REG. OF DEEDS  
*Lucy Bond*


For corners in SECTION  
Kent (County)

Located in:	Grattan Township	Corner Code #
T <u>8N</u> R <u>9W</u>		<u>C-8</u>
T _____ R _____		_____
T _____ R _____		_____
T _____ R _____		_____
S _____ T _____ R _____		_____
S _____ T _____ R _____		_____
S _____ T _____ R _____		_____
S _____ T _____ R _____		_____

10836

Register of Deeds Stamp & File Number

- Public Land Survey
- Property Controlling in Section
- Miscellaneous Property in Sec.
- Lot No. \_\_\_\_\_, Recorded Plat \_\_\_\_\_
- Private Claims \_\_\_\_\_

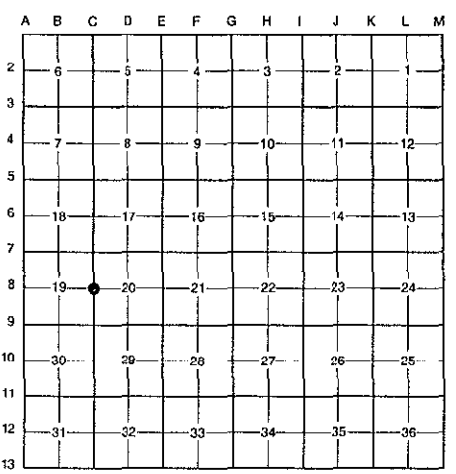

I, Randy Kolehouse, in a field survey on March 25 19 98, do hereby certify that under requirements of P.A. 74 Michigan P.A. of 1970, the corner points mentioned in lines 1 and 2 above were in conformance with regulations and rules therefore as required in the current manual of survey instructions of the United States Department of the interior, Bureau of Land Management or by a decree of a Court of Law and/or that the corner points mentioned in lines 3, 4 and 5 above were in conformance with the rules of the Michigan Board of Land Surveyors or by a Decree of a Court of Law; established, re-established, monumented, re-monumented, recovered, found as expressed below:

NOTE: Not more than 4 corners, all in the same town and range, may be recorded on this certificate.

A. Description of original monument and accessories and/or subsequent restoration:

C-8	1837	G.L.O. Notes	Cathcart	Set Post
	1981	L.C.R.C. #2065	Nederveld & Jonker	Capped Rerod
	1982	L.C.R.C. #2866	Jonker Land Survey	Fnd. Capped Rerod / Set K.C. Monument
	1991	L.C.R.C. #5782	Prein & Newhof	K.C. Monument
	1994	L.C.R.C. #7990	Glaza & Associates	K.C. Monument

P.A. 345 1990 KENT COUNTY  
PEER APPROVED 6/25/98  
CHAIRMAN [Signature]

This corner was originally approved by the Kent County Remonumentation Peer Group and monumented by Rob Jonker on 5/18/82 and was recorded per L.C.R.C. #2866.

- B. Description of corner evidence found and/or method applied in restoring or reestablishing corner:
- C-8 Found a Standard Kent County Monument 275' ± West of West end of tree row running East, 150' East of the C/L of a 2-track running North and South, per L.C.R.C.'s #2866, #5782 and #7990 as set by Rob Jonker in place of a capped rerod he found which checked L.C.R.C. #2065.

L.C.R.C. #2866

L.C.R.C. #7990


Remon. tag on N side 10" W. Cherry N90°E 299.83'  
Remon. tag on E side 10" Maple on Nly. side of woods S10°W 267.97'

K.C. remon tag & nail in N side 16" W. Cherry N90°E 299.65' (m. 299.83')  
K.C. remon tag & nail in E side 16" Maple on Nly side of wood S10°W 267.83' (m. 267.92)  
K.C. remon tag & nail in NW side fence post N60°E 201.90' (m. 201.99')  
K.C. remon tag & nail in W side 2" Twin Yellow Birch on E-W fence line N05°W 127.35' (m. 127.45')

The selected location is accepted by me and is generally accepted by professional surveyors as the best available evidence of the position of the original corner.

- C. Description of monument for corner and accessories established to perpetuate locating the position of the corner:
- C-8 Standard Kent County Monument 16" M/L Below Grade

Nail & K.C. remon. tag on N side 16" W. Cherry N 90° E 299.83'  
Nail & K.C. remon. tag on E side 16" Maple S 10° W 267.92'  
Nail & K.C. remon. tag on NW side fence post N 60° E 201.99'  
Nail & K.C. remon. tag on W side 5" Yellow Birch N 05° W 127.45'  
Two-track running N-S, West 150'  
Tree row running East, E 275'

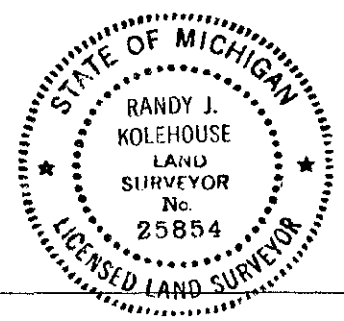

Signed by Randy J. Kolehouse  
EARTH TECH

Date 9-1-98

Surveyor's Michigan License No. 25854