

**SURVEY & REMONUMENTATION**

MAR 08 1999

\$7.00  
\$2.00

**LAND CORNER RECORDATION CERTIFICATE**  
Filing Requirement of Act 74, Mich. P.A. 1970  
KENT COUNTY REMONUMENTATION

For corners in SECTION \_\_\_\_\_

Kent _____ (County)	Located in: Grattan Township	Corner Code # _____
1. Public Land Survey	T <u>8N</u> R <u>9W</u>	<u>C-10</u>
	T _____ R _____	_____
	T _____ R _____	_____
	T _____ R _____	_____
2. Property Controlling in Section	S _____ T _____ R _____	_____
	S _____ T _____ R _____	_____
3. Miscellaneous Property in Sec.	S _____ T _____ R _____	_____
	S _____ T _____ R _____	_____
4. Lot No. _____, Recorded Plat _____		
5. Private Claims _____		

STATE OF MICHIGAN  
COUNTY OF KENT  
RECEIVED FOR RECORD

98 OCT 23 AM 9:58

REG. OF DEEDS  
*Tim Standa*


**10838**  
Register of Deeds Stamp & File Number

I, Randy Kolehouse, in a field survey on January 26 19 98, do hereby certify that under requirements of P.A. 74 Michigan P.A. of 1970, the corner points mentioned in lines 1 and 2 above were in conformance with regulations and rules therefore as required in the current manual of survey instructions of the United States Department of the Interior, Bureau of Land Management or by a decree of a Court of Law and/or that the corner points mentioned in lines 3, 4 and 5 above were in conformance with the rules of the Michigan Board of Land Surveyors or by a Decree of a Court of Law; established, re-established, monumented, re-monumented, recovered, found as expressed below:

**NOTE: Not more than 4 corners, all in the same town and range, may be recorded on this certificate.**

**A. Description of original monument and accessories and/or subsequent restoration:**

C-10	1837	G.L.O. Notes	Cathcart	Set Post
	N/A	Witness Map	K.C. Surveyor	Leaded Stone
	1974	L.C.R.C. #710	Williams & Works	Iron
	1981	L.C.R.C. #2003	Jonker Land Survey	Fnd. "T" Iron / Set K.C. Monument
	1994	L.C.R.C. #7992	Glaza & Associates	K.C. Monument

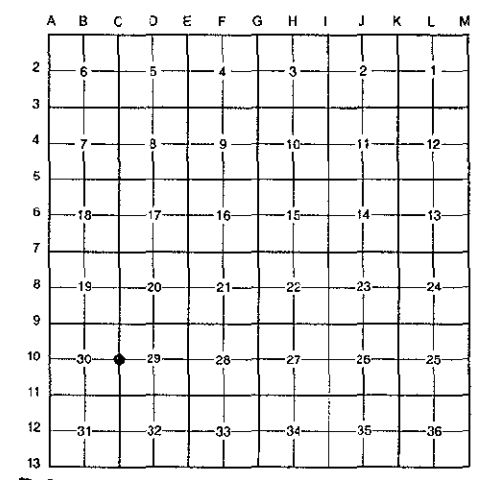

P.A. 345 1990 KENT COUNTY  
PEER APPROVED 6/25/98  
CHAIRMAN Randy Kolehouse

This corner was originally approved by the Kent County Remonumentation Peer Group and monumented by Rob Jonker on 8/14/81 and was recorded per L.C.R.C. #2003.

**B. Description of corner evidence found and/or method applied in restoring or reestablishing corner:**

C-10 Found a Standard Kent County Monument (1.0' ± under water in a swamp) on line of a fence line running East and a tree row running South and West per L.C.R.C.'s #2003 and #7992 as set by Rob Jonker in place of a "T" iron he found which checked L.C.R.C. #710 and the K.C. Surveyor's records.

L.C.R.C. #2003

L.C.R.C. #7992

Remon. tag on W side fence post South 0.96'  
Remon. tag on W side 24" Willow S04°E 38.4'  
Remon. tag on W side 36" Willow N04°W 80.55'


K.C. remon tag & nail in N side fence post East 2.9' (m. 3.00')  
K.C. remon tag & nail in W side 28" Willow S04°E 38.4' (m. 38.35')

The selected location is accepted by me and is generally accepted by professional surveyors as the best available evidence of the position of the original corner.

**C. Description of monument for corner and accessories established to perpetuate locating the position of the corner:**

C-10 Standard Kent County Monument

Nail & K.C. remon. tag on W side fence post East 3.00'  
Nail & K.C. remon. tag on W side 28" Willow (dead) S 04° E 38.35'  
Nail & K.C. remon. tag on W side 36" Willow (stump) N 04° W 80.53'  
Nail & K.C. remon. tag on W side 12" Willow (dead) N 10° W 67.05'  
Nail & K.C. remon. tag on SW side 5" tree S 50° E 23.28'  
On fence line running E  
On tree row running S & W

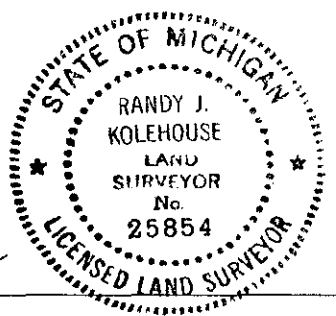

Signed by Randy J. Kolehouse  
EARTH TECH

Date 9-1-98

Surveyor's Michigan License No. 25854