

\$7.00
\$2.00

MAR 08 1999

LAND CORNER RECORDATION CERTIFICATE
Filing Requirement of Act 74, Mich. P.A. 1970
KENT COUNTY REMONUMENTATION

STATE OF MICHIGAN
COUNTY OF KENT
RECEIVED FOR RECORD
38 OCT 23 AM 9:58
REG. OF DEEDS
Lucy Spauld

For corners in


SECTION

Kent (County)	Located in: Grattan Township	Corner Code #
1. Public Land Survey	T <u>8N</u> R <u>9W</u>	<u>C-11</u>
	T _____ R _____	_____
	T _____ R _____	_____
	T _____ R _____	_____
2. Property Controlling in Section	S _____ T _____ R _____	_____
	S _____ T _____ R _____	_____
3. Miscellaneous Property in Sec.	S _____ T _____ R _____	_____
	S _____ T _____ R _____	_____

10839

Register of Deeds Stamp & File Number

- 4. Lot No. _____, Recorded Plat _____
- 5. Private Claims _____

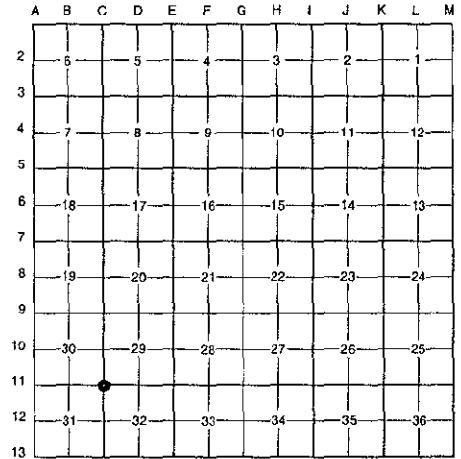

I, Randy Kolehouse, in a field survey on January 26 19 98, do hereby certify that under requirements of P.A. 74 Michigan P.A. of 1970, the corner points mentioned in lines 1 and 2 above were in conformance with regulations and rules therefore as required in the current manual of survey instructions of the United States Department of the interior, Bureau of Land Management or by a decree of a Court of Law and/or that the corner points mentioned in lines 3, 4 and 5 above were in conformance with the rules of the Michigan Board of Land Surveyors or by a Decree of a Court of Law; established, re-established, monumented, re-monumented, recovered, found as expressed below:

NOTE: Not more than 4 corners, all in the same town and range, may be recorded on this certificate.

A. Description of original monument and accessories and/or subsequent restoration:

C-11	1837	G.L.O. Notes	Cathcart	Set Post
	1938	Witness Map	K.C. Surveyor	1/2" Iron Over Stone
	1974	L.C.R.C. #710	Williams & Works	Monument Box
	1981	L.C.R.C. #1881	Jonker Land Survey	Fnd. 1" Rebar in Mon. Box / Set K.C. Monument in Mon. Box
	1982	L.C.R.C. #3097	All-Points Surveyors	K.C. Monument in Monument Box
	1994	L.C.R.C. #7993	Glaza & Associates	K.C. Monument

This corner was originally approved by the Kent County Remonumentation Peer Group and monumented by Rob Jonker on 6/4/81 and was recorded per L.C.R.C. #1881.

B. Description of corner evidence found and/or method applied in restoring or reestablishing corner:

C-11 Found a Standard Kent County Monument in a monument box 4.0' North of the C/L "X" of 5 Mile Road (bit.) running East and West and Parnell Avenue (bit.) running South per L.C.R.C.'s #3097 and #7993 as set by Rob Jonker in place of a 1" rebar he found in a monumet box which checked L.C.R.C.'s #1881, #710, and the K.C. Surveyor's records.

L.C.R.C. #1881

Centerline M.H. West 27.32'
SE cor. Conc. Porch N50°W 41.58'

L.C.R.C. #7993

Centerline of M.H. Wst 27.22' ..
SE corner concrete porch N50°W 41.47' (m. 41.45')
K.C. remon tag & nail in W side P. pole S40°E 81.02' (m. 80.91')

The selected location is accepted by me and is generally accepted by professional surveyors as the best available evidence of the position of the original corner.


C. Description of monument for corner and accessories established to perpetuate locating the position of the corner:

C-11 Standard Kent County Monument in a Monument Box

- C/L of M.H. West 27.22'
- SE corner conc. porch to Parnell Store N 50° W 41.45'
- Nail & K.C. remon. tag on W side P. pole S 40° E 80.91'
- Corner stone (#1877) NE corner St. Patricks Church S 20° W 194.38'
- C/L "X" bit. roads running S-E-W, South 4.0'

P.A. 345 1990 KENT COUNTY

PEER APPROVED 6/29/98
CHAIRMAN *[Signature]*

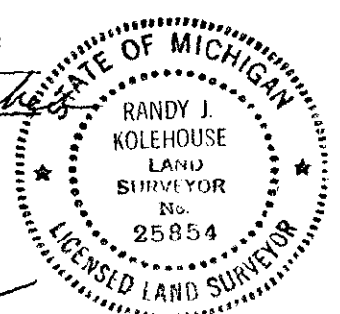

Signed by *Randy J. Kolehouse*
EARTH TECH

Date 9-1-98

Surveyor's Michigan License No. 25854