

SURVEY A
REMONUMENTATION

\$7.00
\$2.00

SEP 08 1999

LAND CORNER RECORDATION CERTIFICATE
Filing Requirement of Act 74, Mich. P.A. 1970
KENT COUNTY REMONUMENTATION

For corners in SECTION


Kent (County)	Located in: Grattan Township	Corner Code #
1. Public Land Survey	T 8N R 9W	C-12
	T _____ R _____	_____
	T _____ R _____	_____
	T _____ R _____	_____
2. Property Controlling in Section	S _____ T _____ R _____	_____
	S _____ T _____ R _____	_____
3. Miscellaneous Property in Sec.	S _____ T _____ R _____	_____
	S _____ T _____ R _____	_____

STATE OF MICHIGAN
COUNTY OF KENT
RECEIVED FOR RECORD
98 OCT 23 AM 9:58
REG. OF DEEDS
Lucy Standa

10840

Register of Deeds Stamp & File Number

4. Lot No. _____, Recorded Plat _____
5. Private Claims _____

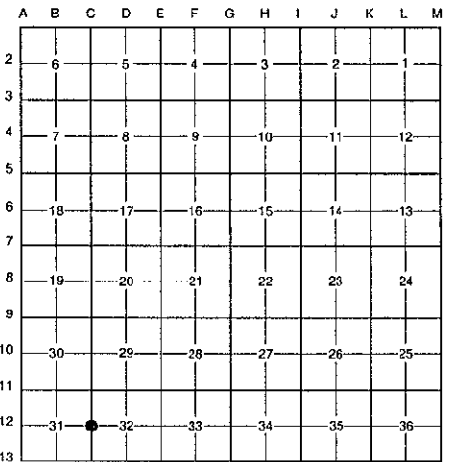

I, Randy Kolehouse, in a field survey on January 26 19 98, do hereby certify that under requirements of P.A. 74 Michigan P.A. of 1970, the corner points mentioned in lines 1 and 2 above were in conformance with regulations and rules therefore as required in the current manual of survey instructions of the United States Department of the interior, Bureau of Land Management or by a decree of a Court of Law and/or that the corner points mentioned in lines 3, 4 and 5 above were in conformance with the rules of the Michigan Board of Land Surveyors or by a Decree of a Court of Law; established, re-established, monumented, re-monumented, recovered, found as expressed below:

NOTE: Not more than 4 corners, all in the same town and range, may be recorded on this certificate.

A. Description of original monument and accessories and/or subsequent restoration:

C-12 1837	G.L.O. Notes	Cathcart	Set Post	P.A. 345 1990 KENT COUNTY
1939	Witness Map	K.C. Surveyor	1" Iron in a Mon. Box	PEER APPROVED 6/25/98
1977	L.C.R.C. #1090	Medema, Van Kooten & Assoc.	1" Iron in Mon. Box	CHAIRMAN <i>Randy Kolehouse</i>
1981	L.C.R.C. #2009	Jonker Land Survey	Fnd. 1" Iron in Mon. Box	Set K.C. Monument in Mon. Box
1994	L.C.R.C. #7994	Glaza & Associates	K.C. Monument	

This corner was originally approved by the Kent County Remonumentation Peer Group and monumented by Rob Jonker on 6/15/81 and was recorded per L.C.R.C. #2009.

B. Description of corner evidence found and/or method applied in restoring or reestablishing corner:

C-12 Found a Standard Kent County Monument in a monument box on the C/L of Parnell Avenue (bit.) running North and South, on line of a fence line and tree row running E-W, per L.C.R.C.'s #2009 and #7994 as set by Rob Jonker in place of a 1" iron he found in a monument box over a 1-1/4" iron 18" below grade which checked L.C.R.C. #1090 and the K.C. Surveyor's records.

L.C.R.C. #2009

L.C.R.C. #7994

Remon. tag on NW side 30" Maple S50°W 37.33'
Remon. tag on S side 30" maple West 27.48'
Remon. tag on S side 24" Hickory East 41.88'


K.C. remon tag & nail in NW side 34" Maple S50°W 37.22' (m. 37.25')
K.C. remon tag & nail in S side 36" Maple West 27.49' (m. 27.58')
K.C. remon tag & nail in S side 30" Hickory East 41.94'
K.C. remon tag & nail in NW side 7" Maple N52°E 33.68' (m. 33.63')

The selected location is accepted by me and is generally accepted by professional surveyors as the best available evidence of the position of the original corner.

C. Description of monument for corner and accessories established to perpetuate locating the position of the corner:

C-12 Standard Kent County Monument in a Monument Box

Nail & K.C. remon. tag on NW side 34" Maple S 50° W 37.25'
Nail & K.C. remon. tag on S side 36" Maple West 27.58'
Nail & K.C. remon. tag on S side 30" Hickory East 41.94'
Nail & K.C. remon. tag on NW side 8" Maple N 52° E 33.63'
On C/L bit. road running N-S
On fence line and tree row running E-W

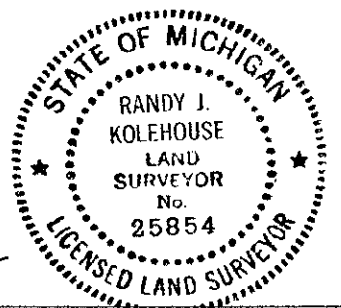

Signed by *Randy J. Kolehouse* Date 9-1-98
EARTH TECH

Surveyor's Michigan License No. 25854