

MAR 08 1999

LAND CORNER RECORDATION CERTIFICATE
Filing Requirement of Act 74, Mich. P.A. 1970
KENT COUNTY REMONUMENTATION

SECTION

For corners in

Kent (County)	Located in:	Grattan Township	Corner Code #
1. Public Land Survey	T <u>8N</u>	R <u>9W</u>	<u>C-13</u>
	T _____	R _____	_____
	T _____	R _____	_____
	T _____	R _____	_____
2. Property Controlling in Section	S _____	T _____	R _____
	S _____	T _____	R _____
3. Miscellaneous Property in Sec.	S _____	T _____	R _____
	S _____	T _____	R _____

STATE OF MICHIGAN
 COUNTY OF KENT
 RECEIVED FOR RECORD
 98 DEC 14 AM 8:00
 REG. OF DEEDS
 10967

Register of Deeds Stamp & File Number

4. Lot No. _____, Recorded Plat _____
 5. Private Claims _____

I, Randy Kolehouse, in a field survey on December 31 19 97, do hereby certify that under requirements of P.A. 74 Michigan P.A. of 1970, the corner points mentioned in lines 1 and 2 above were in conformance with regulations and rules therefore as required in the current manual of survey instructions of the United States Department of the interior, Bureau of Land Management or by a decree of a Court of Law and/or that the corner points mentioned in lines 3, 4 and 5 above were in conformance with the rules of the Michigan Board of Land Surveyors or by a Decree of a Court of Law; established, re-established, monumented, re-monumented, recovered, found as expressed below:

	A	B	C	D	E	F	G	H	I	J	K	L	M
2	6	5	4	3	2	1							
3													
4	7	8	9	10	11	12							
5													
6	18	17	16	15	14	13							
7													
8	19	20	21	22	23	24							
9													
10	30	29	28	27	26	25							
11													
12	31	32	33	34	35	36							
13													

NOTE: Not more than 4 corners, all in the same town and range, may be recorded on this certificate.

A. Description of original monument and accessories and/or subsequent restoration:

C-13	1837	G.L.O. Notes	N. Brookfield	Set Post	P.A. 345 1990 KENT COUNTY
	1959	Witness Map	K.C. Surveyor	Iron	PEER APPROVED <u>9/24/98</u>
	1959	Notes	Williams & Works	Iron	CHAIRMAN <u>Henry Huber</u>
	N/A	Notes	William Byl	Iron	
	1986	L.C.R.C. #4361	R. Kolehouse	Fnd. 1" Iron / Set K.C. Monument	
	1994	L.C.R.C. #7995	Glaza & Associates	K.C. Monument	

Note: This corner is not common with C-1, T7N, R9W.

This corner was originally approved by the Kent County Remonumentation Peer Group and monumented by Randy Kolehouse on 11/16/85 and was recorded per L.C.R.C. #4361.

B. Description of corner evidence found and/or method applied in restoring or reestablishing corner:

C-13 Found a Standard Kent County Monument 62.5' West of the C/L of Parnell Avenue (bit.) running North and South, on line of the C/L of 4 Mile Road (gravel) running East, and on line of a field division line running East per L.C.R.C.'s #4361 and #7995 as set by R. Kolehouse in place of a 1" iron (lying down) he found which checked the K.C. Surveyor's records and the notes of Williams & Works and William Byl.

L.C.R.C. #4361

Nail & K.C. Remon. tag in SW side 6" Hickory N 15° W 7.41'
 Nail & K.C. Remon. tag in E. side 30" Hickory N 30° E 47.20'
 Top C/L N. end 12" conc. culv. East 42.80'
 Top C/L S. end 12" conc. culv. S 80° E 49.25'
 C/L Parnell Ave. (blktop) running N. & S. East 62.5'
 K.C. Monument at the NE cor. section 6 T7N R9W is East 115.50'

L.C.R.C. #7995

Nail & K.C. remon tag in SW side 8" Hickory N21°W 7.43' (m. 7.44')
 Nail & K.C. remon tag in E side 36" Hickory N37°E 47.24' (m. 47.28')
 Top C/L North end 12" concrete culvert East 42.80' (m. 42.83')
 Top C/L South end 12" concrete culvert S80°E 49.25' (m. 49.28')
 C/L Parnell Ave. (blktop) running N & S East 62' (m. 62.5')
 K.C. mon. at the NE corner of Sec 6, T7N, R9W East 115.40'


The selected location is accepted by me and is generally accepted by professional surveyors as the best available evidence of the position of the original corner.

C. Description of monument for corner and accessories established to perpetuate locating the position of the corner:

C-13 Standard Kent County Monument

Nail & K.C. remon. tag on SW side 8" Hickory N 21° W 7.44'
 Nail & K.C. remon. tag on E side 36" Hickory N 37° E 47.28'
 Top C/L North end 12" conc. culvert due East 42.83'
 Top C/L South end 12" conc. culvert S 80° E 49.28'

C/L of bit. road running N-S, East 62.5'
 On line of C/L of gravel road running East
 On line of field division line running East
 K.C. Mon., C-1, T7N, R9W, East 115.40'

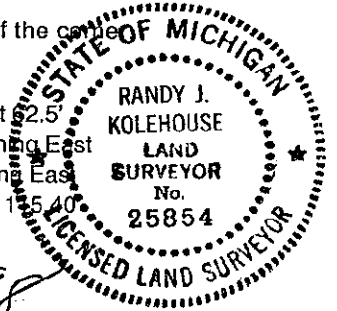

Signed by Randy J. Kolehouse Date 9-30-98
 EARTH TECH

Surveyor's Michigan License No. 25854