SURVEY & REMONUMENTATION

$7.00
$2.00

OCT 08 1998

SECTION

LAND CORNER RECORDATION CERTIFICATE

Filing Requirement of Act 74, Mich. P.A. 1970

KENT COUNTY REMONUMENTATION

For corners in Kent (County) Located in: Grattan Township Corner Code # D-1

STATE OF MICHIGAN
COUNTY OF KENT
RECEIVED FOR RECORD
98 OCT 23 AM 9:58
REG. OF DEEDS
10841

Register of Deeds Stamp & File Number

1. Public Land Survey T 8N R 9W D-1
2. Property Controlling in Section
3. Miscellaneous Property in Sec.

4. Lot No. _____, Recorded Plat _____
5. Private Claims _____

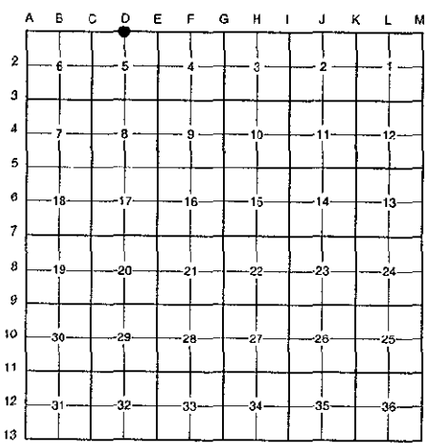

I, Randy Kolehouse, in a field survey on March 2 19 98, do hereby certify that under requirements of P.A. 74 Michigan P.A. of 1970, the corner points mentioned in lines 1 and 2 above were in conformance with regulations and rules therefore as required in the current manual of survey instructions of the United States Department of the Interior, Bureau of Land Management or by a decree of a Court of Law and/or that the corner points mentioned in lines 3, 4 and 5 above were in conformance with the rules of the Michigan Board of Land Surveyors or by a Decree of a Court of Law; established, re-established, monumented, re-monumented, recovered, found as expressed below:

NOTE: Not more than 4 corners, all in the same town and range, may be recorded on this certificate.

A. Description of original monument and accessories and/or subsequent restoration:

D-1 This corner was not originally set by the G.L.O.

1958	Witness Map	K.C. Surveyor	Iron
1958-1966	Notes	Williams & Works	Stake, Stone & Iron
1984	L.C.R.C. #4111	William Byl	Fnd. 1' Iron in Mon. Box / Set K.C. Mon. in Mon. Box
1989	L.C.R.C. #5216	John Bucche	K.C. Monument in a Mon. Box

P.A. 345 1990 KENT COUNTY
PEER APPROVED 6/25/98
CHAIRMAN

Note: This corner is not common with D-13, T9N, R9W.

This corner was originally approved by the Kent County Remonumentation Peer Group and monumented by William Byl on 12/3/84 and was recorded per L.C.R.C. #4111.

B. Description of corner evidence found and/or method applied in restoring or reestablishing corner:

D-1 Found a Standard Kent County Monument in a monument box 4' North of the C/L of 10 Mile Road (bit.) running East and West per L.C.R.C.'s #4111 and #5216 as set by William Byl in place of a 1" iron he found in a monument box on the South line of Sec. 32 and 36.22' West of the South 1/4 corner of Sec. 32 which checked the K.C. Surveyor's records.

L.C.R.C. #4111

Nail & tag, W sd. 20" Oak N 55 E 93.52'
Nail & tag, W sd. 12" Oak N 25 W 65.31'
Nail & tag, W sd. 18" Poplar S 20 E 47.54'
Nail & tag, W sd. Power pole S 25 W 38.58'
Nail & tag, W sd. 24" Maple S 35 W 55.52'

L.C.R.C. #5216

Nail & Remon Tag W side 22" Oak N 55° E 93.38' (m. 93.36')
Nail & Remon Tag W side 16" Oak N 25° W 65.31' (m. 65.26')
Nail & Remon Tag W side 22" Poplar S 20° E 47.54' (m. 47.59')
Nail & Remon Tag W side p. pole S 25° W 38.58' (m. 38.28')
Nail & Remon Tag W side 26" Maple S 35° W 55.52' (m. 55.53')
Nail & Remon Tag W side 12" Oak N 25° W 55.92' (m. 55.86')
K.C. Mon. (D-13, 9-9) East 36.22' (m. 36.23')
C/L Blacktop E-W South 4' +/-

The selected location is accepted by me and is generally accepted by professional surveyors as the best available evidence of the position of the original corner.

C. Description of monument for corner and accessories established to perpetuate locating the position of the corner:

D-1 Standard Kent County Monument in a Monumet Box

Nail & K.C. remon. tag on W side 22" Oak N 55° E 93.36'
Nail & K.C. remon. tag on W side 16" Oak N 25° W 65.26'
Nail & K.C. remon. tag on W side 22" Poplar S 20° E 47.59'
Nail & K.C. remon. tag on W side 26" Maple S 35° W 55.53'
Nail & K.C. remon. tag on W side P. pole S 25° W 38.28'
Nail & K.C. remon. tag on W side 12" Oak N 25° W 55.86'
C/L of bit. road running E-W, South 4.0'
K.C. Mon., D-13, T9N, R9W, East 36.22'

Signed by Randy J. Kolehouse Date 9-1-98
EARTH TECH

Surveyor's Michigan License No. 25854

STATE OF MICHIGAN
RANDY J. KOLEHOUSE
LAND SURVEYOR
No. 25854
LICENSED LAND SURVEYOR

FORM APPROVED BY MICHIGAN STATE BOARD OF LAND SURVEYORS, JAN. 28, 1971
REVISED MAY 14, 1975
REVISED JAN. 1983