

**KENT COUNTY REMONUMENTATION
LAND CORNER RECORDATION CERTIFICATE**
Filing Requirement of Act 74, Mich. P.A. 1970

For corners in

Kent
(County)

Located In:


Corner Code #/1

- | | | |
|------------------------------------|-------------------------|-------------------------|
| 1. Public Land Survey | T <u>8N</u> R <u>9W</u> | D-3 |
| | T _____ R _____ | N $\frac{1}{16}$ corner |
| | T _____ R _____ | Section 8 |
| | T _____ R _____ | Grattan Twp. |
| 2. Property Controlling in Section | S _____ T _____ R _____ | |
| | S _____ T _____ R _____ | |
| 3. Miscellaneous Property in Sec. | S _____ T _____ R _____ | |
| | S _____ T _____ R _____ | |

STATE OF MICHIGAN
COUNTY OF KENT
REGISTER OF DEEDS
6852
Register of Deeds Stamp & File Number
53 NOV 24 PM 1:41

4. Lot No. _____, Recorded Plat _____
5. Private Claims _____

Thomas W. Chettleburgh, in a field survey on March 30, 1993, do hereby certify that under requirements of P.A. 74, Michigan P.A. of 1970, the corner points mentioned in lines 1 and 2 above were in conformance with regulations and rules therefor as required in the current manual of survey instructions of the United States Department of the Interior, Bureau of Land Management or by a decree of a Court of Law and/or that the corner points mentioned in lines 3, 4 and 5 above were in conformance with the rules of the Michigan Board of Land Surveyors or by a Decree of a Court of Law; established, re-established, monumented, re-monumented, recovered, found as expressed below:

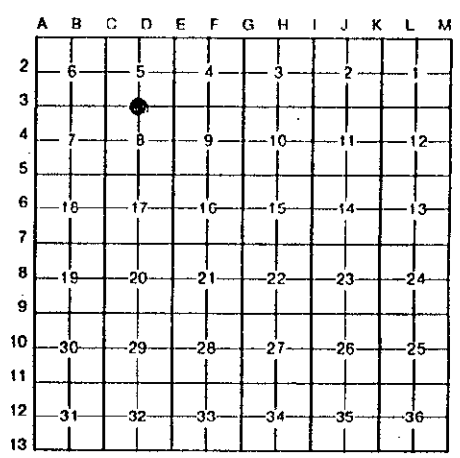

NOTE: Not more than 4 corners, all in the same town and range, may be recorded on this certificate.

A. Description of original monument and accessories and/or subsequent restoration:


- | | |
|---|---|
| Williams & Works, 1895
Set 5' long gas pipe (Not found) | Medema VanKooten, 1978, LCRC #1177
Found 1" Iron (Found-same as M&B, 1972)
18" Walnut NW 48.84'
36" Basswood NE 67.95' |
| Moore & Bruggink, 1972
Found 1 1/4" X 36" Iron Pipe (Found)
C/L Gravel Road North 10.5'
24" Walnut SE 16.11'
21" Basswood SW 13.45'
16" Hickory WSW 31.37' | Moore & Bruggink, 1980, LCRC #1421
1 1/4" X 36" Iron Pipe (held in 1972)
Same witnesses as 1972
Chettleburgh 1991, Replace iron with
Kent County Monument. LCRC #5761 |

B. Description of corner evidence found and/or method applied in restoring or reestablishing corner:

Found Kent County Monument 10.0' ± South of apparent Section lines to East and West. Fence line to East & iron in centerline Wabasis Avenue lines up to a point 10.9' ± North of Monument. Section corner (C-3) to West and 1/16 corner as recorded on Kent County Witness Map (660' ± West) lines up to a point 9.67' North of Monument.
Set corner D-3, Kent County Harrison Monument, by Single proportional measure using Section corner C-3 and above referenced 1/16 corner.
Corner D-3 West 2622.03'
1/16 corner West 655.51'
Remove old Kent County Monument as set by LCRC #5761
South 9.67' & East 2.68'

C. Description of monument for corner and accessories established to perpetuate locating the position of the corner:

- | | | |
|---|-------|--------|
| Kent County Harrison Monument: | | |
| KC Remon tag in SE side of 40" Basswood | N67°E | 65.04' |
| KC Remon tag in N. side of 26" Walnut | S68°E | 66.14' |
| KC Remon tag in NE side of 26" Walnut | S30°E | 26.17' |
| KC Remon tag in N. side of 17" Hickory | S60°W | 33.83' |
| KC Remon tag in SW side of 22" Walnut | N45°W | 40.37' |

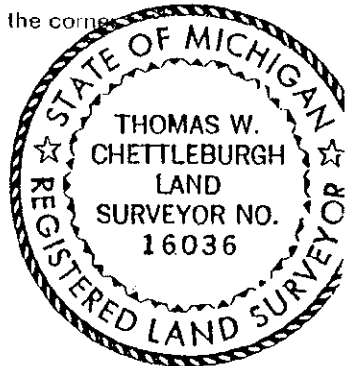

Signed by Thomas W. Chettleburgh Date October 19, 1993
Surveyor's Michigan License No. 16036