

Project No. 92035

Date: 3-24-93

For: K.C. REMONUMENTATION

State of Michigan,


Kent County Register of Deeds

This survey was received for record

on the 13th day of May, 1993 at 11 A. M

Recorded in Liber 253 of surveys Page 44

SECTION 8
T-8-N, R-9-W
GRATTON TWP.

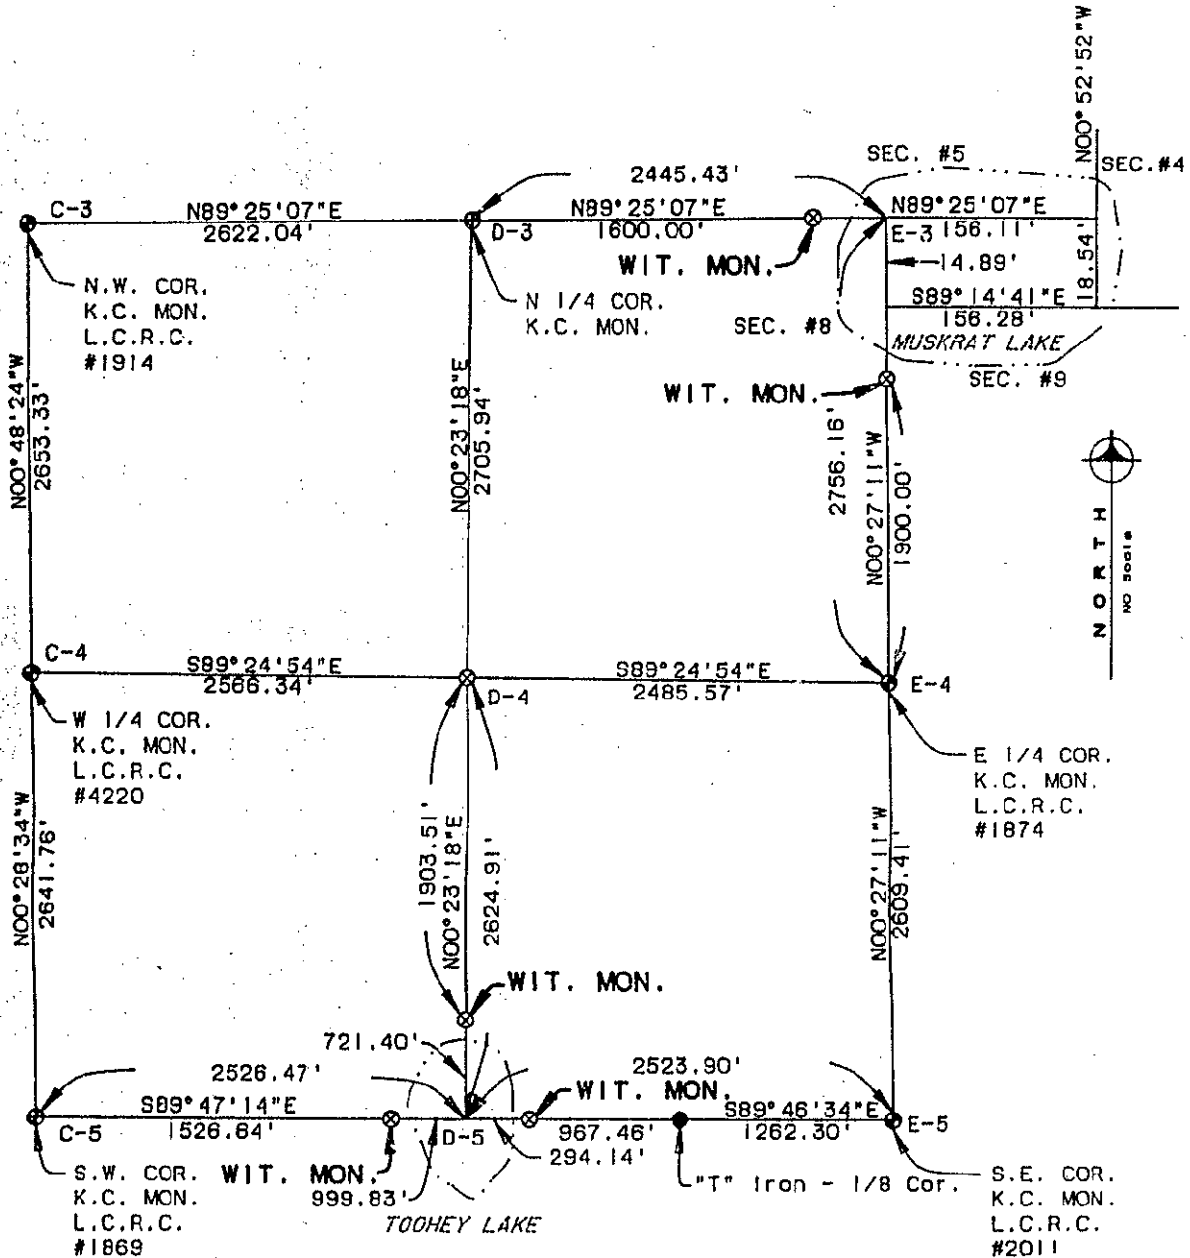

Note: All Bearings Based on Solar Observation

I HEREBY CERTIFY THAT THIS SURVEY MEETS ALL OF THE REQUIREMENTS OF P.A. 132-1978.

LEGEND

- IRON STAKE (FOUND)
- ⊗ MONUMENT (SET)
- ⊙ MONUMENT
- WOOD STAKE
- FENCE LINE
- R RECORDED DIMENSION
- D DEED DIMENSION
- H MEASURED DIMENSION
- E CENTER LINE



omm engineering, Inc.
civil engineers/surveyors
1550 east beltline, se.
grand rapids, mi. 49506.
616-957-4350



Thomas C. Starr

THOMAS C. STARR
Registered Land Surveyor
No. 25874