

MAR 08 1999

\$7.00
\$2.00

SECTION LAND CORNER RECORDATION CERTIFICATE
Filing Requirement of Act 74, Mich. P.A. 1970
KENT COUNTY REMONUMENTATION

For corners in

Kent (County)	Located in:	Grattan Township	Corner Code #
1. Public Land Survey	T <u>8N</u>	R <u>9W</u>	<u>D-7</u>
	T _____	R _____	_____
	T _____	R _____	_____
	T _____	R _____	_____
2. Property Controlling in Section	S _____	T _____	R _____
	S _____	T _____	R _____
3. Miscellaneous Property in Sec.	S _____	T _____	R _____
	S _____	T _____	R _____
4. Lot No. _____, Recorded Plat _____			
5. Private Claims _____			

REG. OF DEEDS

Luigi Standa

38 OCT 23 AM 9:58


STATE OF MICHIGAN
 COUNTY OF KENT
 RECEIVED FOR RECORD

10846

Register of Deeds Stamp & File Number

I, Randy Kolehouse, in a field survey on February 3 19 98, do hereby certify that under requirements of P.A. 74 Michigan P.A. of 1970, the corner points mentioned in lines 1 and 2 above were in conformance with regulations and rules therefore as required in the current manual of survey instructions of the United States Department of the Interior, Bureau of Land Management or by a decree of a Court of Law and/or that the corner points mentioned in lines 3, 4 and 5 above were in conformance with the rules of the Michigan Board of Land Surveyors or by a Decree of a Court of Law; established, re-established, monumented, re-monumented, recovered, found as expressed below:

NOTE: Not more than 4 corners, all in the same town and range, may be recorded on this certificate.

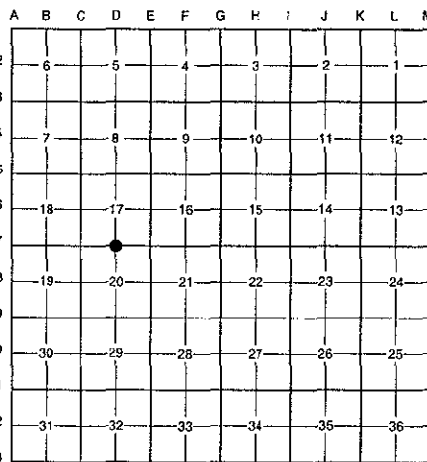

A. Description of original monument and accessories and/or subsequent restoration:

D-7	1837	G.L.O. Notes	Cathcart	Set Post
	1959	Witness Map	K.C. Surveyor	1" Iron Pipe
	1971	L.C.R.C. #97	Williams & Works	1" Iron in Monument Box
	1981	L.C.R.C. #1875	Jonker Land Survey	Fnd. "T" Iron in Mon. Box / Set K.C. Monument in Mon. Box
	1991	L.C.R.C. #5779	Prein & Newhof	K.C. Monument in a Mon. Box
	1994	L.C.R.C. #8005	Glaza & Associates	K.C. Monument

This corner was originally approved by the Kent County Remonumentation Peer Group and monumented by Rob Jonker on 6/11/98 and was recorded per L.C.R.C. #1875.

B. Description of corner evidence found and/or method applied in restoring or reestablishing corner:

D-7 Found a Standard Kent County Monument at the C/L intersection of 7 Mile Road (gravel) running East and West and Gavin Lake Road (bit.) running North and South per L.C.R.C.'s #1875, #5779 and #8005 as set by Rob Jonker in place of a "T" iron he found in a monument box over a 1/2" round iron 1.5' below grade which checked L.C.R.C. #97 and the K.C. Surveyor's records.

L.C.R.C. #1875

L.C.R.C. #8005

Remon. tag on NW side p. pole S62°W 157.80'
 C/L MBT Riser N32°E 69.3'
 On C/L "X" of B.T.

K.C. remon tag & nail in NW side P. pole S62°W 157.76' (m. 157.74')
 C/L MBT riser N32°E 69.28' (m. 69.34')
 On C/L "X" of B.T.
 K.C. remon tag & nail in N side 12" Mulberry S65°E 91.72' (m. 91.64')
 K.C. remon tag & nail in S side P. pole N70°W 138.50' (m. 138.69')

The selected location is accepted by me and is generally accepted by professional surveyors as the best available evidence of the position of the original corner.


C. Description of monument for corner and accessories established to perpetuate locating the position of the corner:

D-7 Standard Kent County Monument

Nail & K.C. remon. tag on NW side P. pole S 62° W 157.74'
 Nail & K.C. remon. tag on N side 12" Mulberry S 65° E 91.64'
 C/L MBT Riser N 32° E 69.34'
 Nail & K.C. remon. tag on S side P. pole N 70° W 138.69'
 Nail & K.C. remon. tag on NE side P. pole N 44° W 53.84'
 On C/L "X" of gravel road running E-W and bit. road running N-S

P.A. 345 1990 KENT COUNTY

PEER APPROVED 6/25/98
 CHAIRMAN Randy Kolehouse

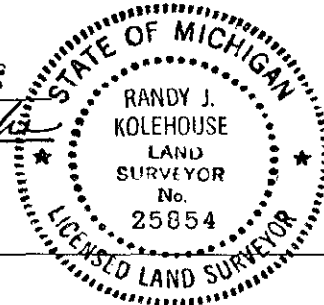

Signed by Randy J. Kolehouse Date 9-1-98
 EARTH TECH

Surveyor's Michigan License No. 25854