

MAR 08 1999

LAND CORNER RECORDATION CERTIFICATE
Filing Requirement of Act 74, Mich. P.A. 1970
KENT COUNTY REMONUMENTATION

For corners in	SECTION	Located in:	Grattan Township	Corner Code #
Kent (County)				
1. Public Land Survey	T <u>8N</u>	R <u>9W</u>		<u>D-8</u>
	T _____	R _____		_____
	T _____	R _____		_____
	T _____	R _____		_____
2. Property Controlling in Section	S _____	T _____	R _____	_____
	S _____	T _____	R _____	_____
3. Miscellaneous Property in Sec.	S _____	T _____	R _____	_____
	S _____	T _____	R _____	_____


STATE OF MICHIGAN
 COUNTY OF KENT
 RECEIVED FOR RECORD
 38 DEC 14 AM 8:00
 REG. OF DEEDS
Lucy Stand

10968

Register of Deeds Stamp & File Number

4. Lot No. _____, Recorded Plat _____
 5. Private Claims _____

I, Randy Kolehouse, in a field survey on March 2 19 98, do hereby certify that under requirements of P.A. 74 Michigan P.A. of 1970, the corner points mentioned in lines 1 and 2 above were in conformance with regulations and rules therefore as required in the current manual of survey instructions of the United States Department of the interior, Bureau of Land Management or by a decree of a Court of Law and/or that the corner points mentioned in lines 3, 4 and 5 above were in conformance with the rules of the Michigan Board of Land Surveyors or by a Decree of a Court of Law; established, re-established, monumented, re-monumented, recovered, found as expressed below:

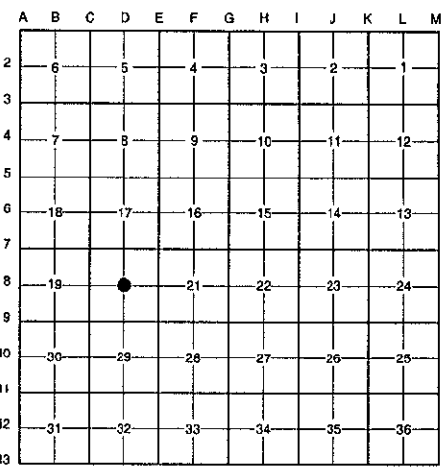

NOTE: Not more than 4 corners, all in the same town and range, may be recorded on this certificate.

A. Description of original monument and accessories and/or subsequent restoration:

D-8	This corner was not originally set by the G.L.O.		
1981	L.C.R.C. #2065	Nedervold and Jonker	Capped Rerod
1981	Cert. Survey L. 119 P. 16-19	Nedervold and Jonker	Cap on Rerod
1983	Survey	B. Wickham	Capped Iron
1991	Cert. Survey L. 236 P. 42	Prein & Newhof	Capped Re-Rod
1991	L.C.R.C. #5783	Prein & Newhof	Capped Iron

P.A. 345 1990 KENT COUNTY
 PEER APPROVED 11/22/98
 CHAIRMAN *Harry Kube*

B. Description of corner evidence found and/or method applied in restoring or reestablishing corner:

D-8 Found a 1/2" rebar on the C/L of Gavin Lake Road (bit.) running North and South, on line of a tree row running East, per witnesses from above. Rebar is 0.1' South and 0.2' East of the intersection of 1/4 lines. Accepted rebar as Center of Section.

L.C.R.C. #5783

- Nail in Iron NE 1.66'
- Iron E. 33.0' (m. 32.96')
- C/L B.T. W. 0.5' +/-
- + on E. side 3" steel pole S25°W 149.17' (m. 149.20')
- Nail & Remon. tag N. side P. Pole N90°E 26.81' (m. 26.75')
- Nail & Remon. tag E. side 10" Elm N10°W 98.95' (m. 98.93')

The selected location is accepted by me and is generally accepted by professional surveyors as the best available evidence of the position of the original corner.

C. Description of monument for corner and accessories established to perpetuate locating the position of the corner:

- D-8 Replaced 1/2" Rebar with a Standard Kent County Monument
- Nail & K.C. remon. tag on NW side 8" Elm S 45° W 37.72'
- Nail & K.C. remon. tag on S side P. pole S 70° W 26.65'
- Nail in Iron NE 1.66'
- C/L B.T. W 0.5' +/- on E side 3" steel pole S 25° W 149.20'
- Nail & K.C. remon. tag on N side P. pole N 90° E 26.75'
- Nail & K.C. remon. tag on E side 10" Elm N 10° W 98.93'
- On C/L of bit. road running N-S
- On tree row running E



Signed by *Randy J. Kolehouse* Date 11/18/98

Surveyor's Michigan License No. 25854