

SEP 08 1998

LAND CORNER RECORDATION CERTIFICATE
Filing Requirement of Act 74, Mich. P.A. 1970
KENT COUNTY REMONUMENTATION

STATE OF MICHIGAN
COUNTY OF KENT
RECEIVED FOR RECORDS
38 OCT 23 AM 9:58
REG. OF DEEDS

For corners in


SECTION

Table with columns: Kent (County), Located in: Grattan Township, Corner Code #. Rows include Public Land Survey, Property Controlling in Section, and Miscellaneous Property in Sec.

10847
Register of Deeds Stamp & File Number

4. Lot No. , Recorded Plat
5. Private Claims

I, Randy Kolehouse, in a field survey on February 2, 1998, do hereby certify that under requirements of P.A. 74 Michigan P.A. of 1970, the corner points mentioned in lines 1 and 2 above were in conformance with regulations and rules therefore as required in the current manual of survey instructions of the United States Department of the interior, Bureau of Land Management or by a decree of a Court of Law and/or that the corner points mentioned in lines 3, 4 and 5 above were in conformance with the rules of the Michigan Board of Land Surveyors or by a Decree of a Court of Law; established, re-established, monumented, re-monumented, recovered, found as expressed below:

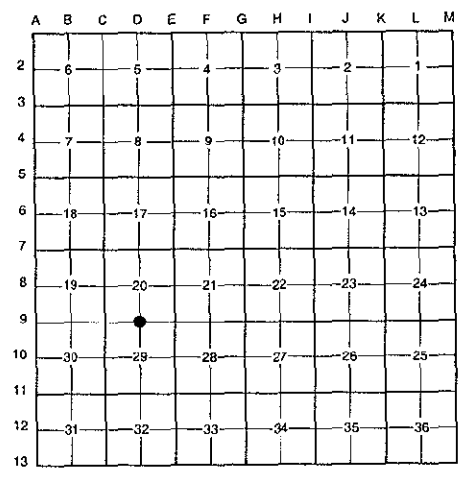

NOTE: Not more than 4 corners, all in the same town and range, may be recorded on this certificate.

A. Description of original monument and accessories and/or subsequent restoration:

Table with columns: D-9, 1837, G.L.O. Notes, Cathcart, Set Post, 1959, Witness Map, K.C. Surveyor, Iron, 1980, L.C.R.C. #1388, Nederveld & Jonker, Iron, 1981, L.C.R.C. #2010, Jonker Land Survey, Fnd. Square Spike / Set K.C. Monument, 1994, L.C.R.C. #8006, Glaza & Associates, K.C. Monument

This corner was originally approved by the Kent County Remonumentation Peer Group and monumented by Rob Jonker on 6/15/81 and was recorded per L.C.R.C. #2010.

B. Description of corner evidence found and/or method applied in restoring or reestablishing corner:

D-9 Found a Standard Kent County Monument 2' North of the C/L of Crooked Lake Road (bit.) running East and West and 125' ± East of the C/L of Gavin Lake Road (bit.) running North and South per L.C.R.C.'s #2010 and #8006 as set by Rob Jonker in place of a square spike he found which checked L.C.R.C. #1388 and the K.C. Surveyor's records.

Table comparing L.C.R.C. #2010 and L.C.R.C. #8006 measurements for NW cor. milk house, NW cor. barn, SW cor. conc. hse. fnd., Remon. tag on S side p. pole, and C/L B.T. 2' S.

The selected location is accepted by me and is generally accepted by professional surveyors as the best available evidence of the position of the original corner.

C. Description of monument for corner and accessories established to perpetuate locating the position of the corner:

D-9 Standard Kent County Monument

- Nail & K.C. remon. tag on S side P. pole S 77° W 78.99'
Nail & K.C. remon. tag on S side P. pole N 83° E 127.64'
SW cor. conc. fndn. To hse. 5214 N 20° W 94.77'
NW cor. milk house S 11° E 35.50'
NW cor. barn S 32° W 44.90'
C/L of bit. road running E-W, South 2'
C/L of bit. road running N-S, West 125'

P.A. 345 1990 KENT COUNTY
PEER APPROVED 6/25/98
CHAIRMAN [Signature]



Signed by Randy J. Kolehouse Date 9-1-98
EARTHTECH

Surveyor's Michigan License No. 25854