

SURVEY & REMONUMENTATION

MAR 08 1999

LAND CORNER RECORDATION CERTIFICATE  
Filing Requirement of Act 74, Mich. P.A. 1970  
KENT COUNTY REMONUMENTATION

For corners in

Kent (County)	SECTION	Located in:	Grattan Township	Corner Code #
1. Public Land Survey	T 8N	R 9W		D-10
	T	R		
	T	R		
	T	R		
2. Property Controlling in Section	S	T	R	
3. Miscellaneous Property in Sec.	S	T	R	

REG. OF DEEDS

*W. J. Kulehouse*

38 DEC 14 AM 8:00

STATE OF MICHIGAN  
COUNTY OF KENT  
RECEIVED FOR RECORDS

10969

Register of Deeds Stamp & File Number

4. Lot No. \_\_\_\_\_, Recorded Plat \_\_\_\_\_  
5. Private Claims \_\_\_\_\_

I, Randy Kulehouse, in a field survey on February 26 19 98, do hereby certify that under requirements of P.A. 74 Michigan P.A. of 1970, the corner points mentioned in lines 1 and 2 above were in conformance with regulations and rules therefore as required in the current manual of survey instructions of the United States Department of the interior, Bureau of Land Management or by a decree of a Court of Law and/or that the corner points mentioned in lines 3, 4 and 5 above were in conformance with the rules of the Michigan Board of Land Surveyors or by a Decree of a Court of Law; established, re-established, monumented, re-monumented, recovered, found as expressed below:

NOTE: Not more than 4 corners, all in the same town and range, may be recorded on this certificate.

A. Description of original monument and accessories and/or subsequent restoration:


D-10 This corner was not originally set by the G.L.O.

1953	Survey Records	Williams & Works	Set Iron at Int. of 1/4 Lines
1954-1984	Survey Records	Williams & Works	Iron
1973	L.C.R.C. #385	Williams & Works	3/4" Iron
1973	Cert. Survey L. 13 P. 33	Williams & Works	3/4" iron
1978	Cert. Survey L. 81 P. 45	Williams & Works	Iron Pipe
1984	Cert. Survey L. 150 P. 37	Williams & Works	Iron

P.A. 345 1990 KENT COUNTY

PEER APPROVED 10/22/98

CHAIRMAN *Henry Kulehouse*

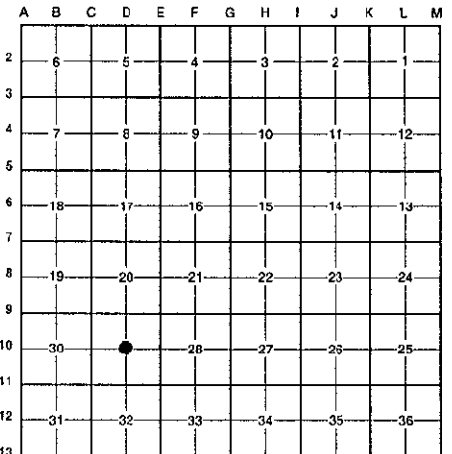

B. Description of corner evidence found and/or method applied in restoring or reestablishing corner:

D-10 Found a 3/4" iron pipe as set by Williams & Works at the intersection of 1/4 lines 36' ± South of the C/L of Keystone Road (gravel) running East, on line of a tree row running North, and 3' ± North of a fence line running East and West per L.C.R.C. #385, the Cert. Surveys indicated above, and the 1954-84 survey records of Williams & Works. Iron pipe is 1.0' North of the intersection of 1/4 lines. Accepted iron as Center of Section.

L.C.R.C. #385

CP/MBT pole N 61.71' (m. 61.69)

4" Poplar N65°W 8.05' (m. 7.75')

The selected location is accepted by me and is generally accepted by professional surveyors as the best available evidence of the position of the original corner.

C. Description of monument for corner and accessories established to perpetuate locating the position of the corner:

D-10 Replaced Iron Pipe with a Standard Kent County Monument

- Spike in NE side 8" Poplar (dead and leaning NE) N 65° W 7.75'
- Nail & K.C. remon. tag on E side P. pole N 05° E 61.69'
- Nail & K.C. remon. tag on N side 8" Poplar N 65° E 2.38'
- Nail & K.C. remon. tag on N side 8" Poplar S 65° E 11.92'
- Nail & K.C. remon. tag on W side 5" Poplar N 35° E 8.25'
- Nail & K.C. remon. tag on E side 10" Poplar N 12° W 9.54'
- C/L of gravel road running E, North 36'
- On tree row running N
- Fence line running E-W, South 3'

Signed by *Randy J. Kulehouse*

Date 11/18/98

EARTH TECH

Surveyor's Michigan License No. 25854

