

DEC 08 1998

87.00
82.00

LAND CORNER RECORDATION CERTIFICATE
Filing Requirement of Act 74, Mich. P.A. 1970
KENT COUNTY REMONUMENTATION

SECTION


For corners in

Kent (County)	Located in:	Grattan Township	Corner Code #
1. Public Land Survey	T <u>8N</u>	R <u>9W</u>	<u>D-11</u>
	T _____	R _____	_____
	T _____	R _____	_____
	T _____	R _____	_____
2. Property Controlling in Section	S _____	T _____	R _____
	S _____	T _____	R _____
3. Miscellaneous Property in Sec.	S _____	T _____	R _____
	S _____	T _____	R _____

STATE OF MICHIGAN
COUNTY OF KENT
RECEIVED FOR RECORDING
38 OCT 23 AM 9:58
REG. OF DEEDS
Lucy Stand
10848
Register of Deeds Stamp & File Number

4. Lot No. _____, Recorded Plat _____
5. Private Claims _____

I, Randy Kolehouse, in a field survey on January 26 19 98, do hereby certify that under requirements of P.A. 74 Michigan P.A. of 1970, the corner points mentioned in lines 1 and 2 above were in conformance with regulations and rules therefore as required in the current manual of survey instructions of the United States Department of the interior, Bureau of Land Management or by a decree of a Court of Law and/or that the corner points mentioned in lines 3, 4 and 5 above were in conformance with the rules of the Michigan Board of Land Surveyors or by a Decree of a Court of Law; established, re-established, monumented, re-monumented, recovered, found as expressed below:

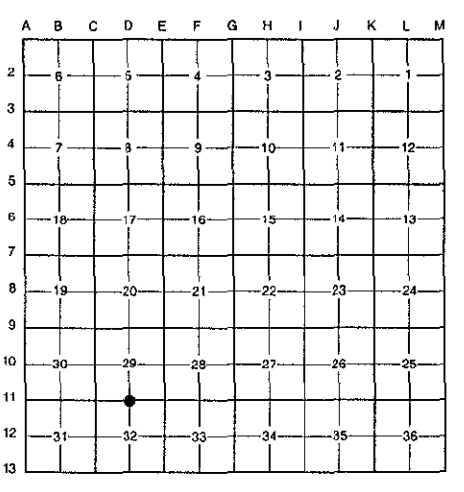

NOTE: Not more than 4 corners, all in the same town and range, may be recorded on this certificate.

A. Description of original monument and accessories and/or subsequent restoration:

D-11	1837	G.L.O. Notes	Cathcart	Set Post
	1944	Witness Map	K.C. Surveyor	1" Iron
	1977	L.C.R.C. #1230	William Byl	1" Iron
	1980	L.C.R.C. #1396	Williams & Works	1" Iron
	1981	L.C.R.C. #1879	Jonker Land Survey	Fnd. 1" Iron / Set K.C. Monument
	1984	L.C.R.C. #3996	Randy Kolehouse	Replaced 1" Iron in Mon. Box / Set K.C. Monument in Mon. Box
	1994	L.C.R.C. #8007	Glaza & Associates	K.C. Monument

P.A. 345 1990 KENT COUNTY
PEER APPROVED 6/25/98
CHAIRMAN *[Signature]*

This corner was originally approved by the Kent County Remonumentation Peer Group and monumented by Rob Jonker on 6/5/98 and was recorded per L.C.R.C. #1879.

B. Description of corner evidence found and/or method applied in restoring or reestablishing corner:

D-11 Found a Standard Kent County Monument in a monument box .5' North of the C/L of 5 Mile Road (bit.) running East and West per L.C.R.C.'s #1879, #3996 and #8007 as set by Rob Jonker in place of a 1" iron he found at grade over a 4"x36" plat monument 1.0' below grade which checked L.C.R.C.'s #1396, #1230 and the K.C. Surveyor's records and reset by Randy Kolehouse in 1984 in place of a 1" iron in a monument box he found which checked L.C.R.C. 1879.

L.C.R.C. #1879

L.C.R.C. #8007

- Remon. tag on N. side P. pole S60°E 202.10'
- Nail & K.C. remon tag in top wood post N65°W 81.74' (m. 81.68')
- Nail & K.C. remon tag in top wood post N50°E 84.00' (m. 84.00')
- Nail & K.C. remon tag in top wood post S40°W 60.33' (m. 60.66')
- Nail & K.C. remon tag in W side guard rail post S10°E 23.45' (m. 23.46')
- Nail & K.C. remon tag in N side P. pole S60°W 134.35' (m. 134.10')

The selected location is accepted by me and is generally accepted by professional surveyors as the best available evidence of the position of the original corner.

C. Description of monument for corner and accessories established to perpetuate locating the position of the corner:

- D-11 Standard Kent County Monument in a Monument Box
- Nail & K.C. remon. tag on top of wood post N 65° W 81.68'
 - Nail & K.C. remon. tag on top of wood post N 50° E 84.00'
 - Nail & K.C. remon. tag on top of wood post S 40° W 60.66'
 - Nail & K.C. remon. tag on W side guard rail post S 10° E 23.46'
 - Nail & K.C. remon. tag on N side P. pole S 60° W 134.10'
 - C/L of bit. road running E-W, South .5'



Signed by Randy J. Kolehouse
EARTH TECH
Surveyor's Michigan License No. 25854

Date 9-1-98