

**SURVEY &
REMONUMENTATION**

**\$7.00
\$2.00**

MAR 08 1999

LAND CORNER RECORDATION CERTIFICATE
Filing Requirement of Act 74, Mich. P.A. 1970
KENT COUNTY REMONUMENTATION

For corners in


SECTION

<u>Kent</u> (County)	Located in:	Grattan Township	Corner Code #
1. Public Land Survey	T <u>8N</u>	R <u>9W</u>	<u>D-13</u>
	T _____	R _____	_____
	T _____	R _____	_____
	T _____	R _____	_____
2. Property Controlling in Section	S _____	T _____	R _____
	S _____	T _____	R _____
3. Miscellaneous Property in Sec.	S _____	T _____	R _____
	S _____	T _____	R _____
4. Lot No. _____, Recorded Plat _____			
5. Private Claims _____			

STATE OF MICHIGAN
 COUNTY OF KENT
 RECEIVED FOR RECORD
 98 DEC 14 AM 8:00
 REG. OF DEEDS
Luci St. Grand

10971
Register of Deeds Stamp & File Number

I, Randy Kolehouse, in a field survey on December 31 19 97, do hereby certify that under requirements of P.A. 74 Michigan P.A. of 1970, the corner points mentioned in lines 1 and 2 above were in conformance with regulations and rules therefore as required in the current manual of survey instructions of the United States Department of the interior, Bureau of Land Management or by a decree of a Court of Law and/or that the corner points mentioned in lines 3, 4 and 5 above were in conformance with the rules of the Michigan Board of Land Surveyors or by a Decree of a Court of Law; established, re-established, monumented, re-monumented, recovered, found as expressed below:

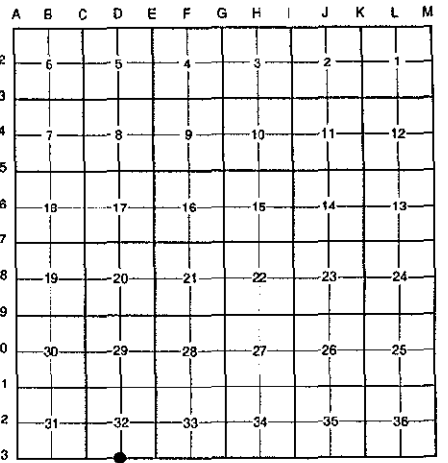

NOTE: Not more than 4 corners, all in the same town and range, may be recorded on this certificate.

A. Description of original monument and accessories and/or subsequent restoration:

D-13	1837	G.L.O. Notes	N. Brookfield	80" Tree
	1977	L.C.R.C. #1231	William Byl	1/2" Re-rod & Cap
	1981	L.C.R.C. #1732	Williams & Works	Fnd. 1/2" Re-rod & Cap / Set K.C. Monument
	1994	L.C.R.C. #8008	Glaza & Associates	K.C. Monument

P.A. 345 1990 KENT COUNTY
 PEER APPROVED 9/29/98
 CHAIRMAN *Randy Kolehouse*

Note: This corner is not common with D-1, T7N, R9W.

This corner was originally approved by the Kent County Remonumentation Peer Group and monumented by Williams & Works on 1/6/81 and was recorded per L.C.R.C. #1732.

B. Description of corner evidence found and/or method applied in restoring or reestablishing corner:

D-13 Found a Standard Kent County Monument 3' South of the C/L of 4 Mile Road (gravel) running East and West per L.C.R.C.'s #1732 and #8008 as set by Williams & Works in place of a 1/2" re-rod and cap they found which checked L.C.R.C. #1231.

L.C.R.C. #1732

- Nail & K.C. Remon. Tag in NE Side of 14" Ash S 20°E 28.85'
- Nail & K.C. Remon. Tag in South Side 10" Maple S 80°W 39.98'
- Nail & K.C. Remon. Tag in SE Side 12" Ash S 35°W 48.94'
- Nail & K.C. Remon. Tag in SW Side 10" Maple S 50°E 52.88'

L.C.R.C. #8008


- Nail & K.C. remon tag in NE side 18" Ash S20°E 28.65' (m. 28.62')
- Nail & K.C. remon tag in S side 12" Maple S80°W 39.88' (m. 39.86')
- Nail & K.C. remon tag in SE side 12" Ash S35°W 48.75' (m. 48.74')
- Nail & K.C. remon tag in SW side 16" Maple S50°E 52.73' (m. 52.71')
- K.C. mon. at the N 1/4 cor of Sec 5, T7N, R9W N90°E 94.32'

The selected location is accepted by me and is generally accepted by professional surveyors as the best available evidence of the position of the original corner.

C. Description of monument for corner and accessories established to perpetuate locating the position of the corner:

D-13 Standard Kent County Monument

- Nail & K.C. remon. tag on NE side 18" Ash S 20° E 28.62'
- Nail & K.C. remon. tag on S side 12" Maple S 80° W 39.86'
- Nail & K.C. remon. tag on SE side 12" Ash S 35° W 48.74'
- Nail & K.C. remon. tag on SW side 16" Maple S 50° E 52.71'
- C/L of gravel road running E-W, North 3'
- K.C. Mon., D-1, T7N, R9W, N 90° E 94.32'

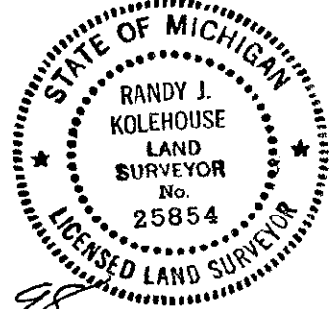

Signed by Randy J. Kolehouse Date 9-30-98
 EARTH TECH
 Surveyor's Michigan License No. 25854