

\$7.00
\$2.00

APR 08 1999

LAND CORNER RECORDATION CERTIFICATE
Filing Requirement of Act 74, Mich. P.A. 1970
KENT COUNTY REMONUMENTATION

For corners in

SECTION


Kent (County)	Located in:	Grattan Township	Corner Code #
1. Public Land Survey	T <u>8N</u>	R <u>9W</u>	<u>E-1</u>
	T _____	R _____	_____
	T _____	R _____	_____
	T _____	R _____	_____
2. Property Controlling in Section	S _____	T _____	R _____
	S _____	T _____	R _____
3. Miscellaneous Property in Sec.	S _____	T _____	R _____
	S _____	T _____	R _____

STATE OF MICHIGAN
COUNTY OF KENT
RECEIVED FOR RECORD
38 OCT 23 AM 9:58
REG. OF DEEDS
Eric Spang

10849

Register of Deeds Stamp & File Number

- 4. Lot No. _____, Recorded Plat _____
- 5. Private Claims _____

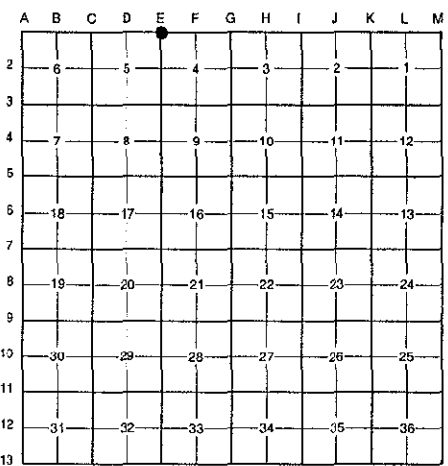

I, Randy Kolehouse, in a field survey on March 2 19 98, do hereby certify that under requirements of P.A. 74 Michigan P.A. of 1970, the corner points mentioned in lines 1 and 2 above were in conformance with regulations and rules therefore as required in the current manual of survey instructions of the United States Department of the interior, Bureau of Land Management or by a decree of a Court of Law and/or that the corner points mentioned in lines 3, 4 and 5 above were in conformance with the rules of the Michigan Board of Land Surveyors or by a Decree of a Court of Law; established, re-established, monumented, re-monumented, recovered, found as expressed below:

NOTE: Not more than 4 corners, all in the same town and range, may be recorded on this certificate.

A. Description of original monument and accessories and/or subsequent restoration:

E-1	1837	G.L.O. Notes	Cathcart	Set Post
	N/A	Witness Map	K.C. Surveyor	Stone and Stake
	1895-1958	Notes	Williams & Works	Stone - Iron
	1985	L.C.R.C. #4112	William Byl	Fnd. 1" Pinched Pipe in Mon. Box
	1989	L.C.R.C. #5217	John Bueche	K.C. Monument

P.A. 345 1990 KENT COUNTY
PEER APPROVED 6/29/98
CHAIRMAN Randy Kolehouse

Note: This corner is not common with E-13, T9N, R9W.

This corner was originally approved by the Kent County Remonumentation Peer Group and monumented by William Byl on 11/1/84 and was recorded per L.C.R.C. 4112.

B. Description of corner evidence found and/or method applied in restoring or reestablishing corner:

E-1 Found a Standard Kent County Monument in a monument box on the C/L of 10 Mile Road (bit.) running East and West, 115' West of a tree row running North, per L.C.R.C.'s #4112 and #5217 as set by William Byl in place of a 1" pinched pipe he found in a monument box on the South line of Sec. 32 and 72.58' West of the SE corner of Sec. 32. Pipe was 20" below surface, within 0.1' of iron at surface. Pinched pipe checked the 1895-1958 notes of Williams & Works and the K.C. Surveyor's records.

L.C.R.C. #4112

L.C.R.C. #5217

Nail & tag, S sd. Power pole N 75° W 146.68'
Nail & tag, N sd. 12" Hickory N 45° E 101.46'
"X" cut in top W end 12" culvert N 60° W 48.56'
"X" cut in top E end 12" culvert N 35° W 30.85'
C/L top MBT pedestal #11228 S 70° E 79.76'

Nail & Remon Tag S side p. pole N 75° W 146.68' (m. 146.75')
Nail & Remon Tag N side 16" Hickory N 45° E 101.46' (m. 100.88')
"X" Cut in top W end 12" culvert N 60° W 48.56' (m. 48.54')
"X" Cut in top E end 12" culvert N 35° W 30.85'
C/L top MBT pedestal #11228 S 70° E 79.76'
K.C. Mon. (E-13, 9-9) East 72.58'

The selected location is accepted by me and is generally accepted by professional surveyors as the best available evidence of the position of the original corner.

C. Description of monument for corner and accessories established to perpetuate locating the position of the corner:

E-1 Standard Kent County Monument in a Monument Box

Nail & K.C. remon. tag on S side P. pole N 75° W 146.75'
Nail & K.C. remon. tag on N side 16" Hickory N 45° E 100.88'
"X" cut in top W end 12" culvert N 60° W 48.54'
"X" cut in top E end 12" culvert N 35° W 30.85'
C/L top MBT pedestal #11228 S 70° E 79.76'

On C/L of bit. road running E-W
Tree row running N, East 115'
K.C. Mon., E-13, T9N, R9W, East 72.58'

Signed by Randy J. Kolehouse Date 9-1-98
EARTH TECH

Surveyor's Michigan License No. 25854

