

SURVEY & REMONUMENTATION

MAR 08 1999

LAND CORNER RECORDATION CERTIFICATE
Filing Requirement of Act 74, Mich. P.A. 1970
KENT COUNTY REMONUMENTATION

For corners in **SECTION**

Kent (County)	Located in: Grattan Township	Corner Code #
1. Public Land Survey	T <u>8N</u> R <u>9W</u>	<u>E-2</u>
	T _____ R _____	_____
	T _____ R _____	_____
	T _____ R _____	_____
2. Property Controlling in Section	S _____ T _____ R _____	_____
	S _____ T _____ R _____	_____
3. Miscellaneous Property in Sec.	S _____ T _____ R _____	_____
	S _____ T _____ R _____	_____


STATE OF MICHIGAN
 COUNTY OF KENT
 RECEIVED FOR RECORD
 38 DEC 23 AM 8:57
 REG. OF DEEDS
Luis Standa

11071

Register of Deeds Stamp & File Number

- 4. Lot No. _____, Recorded Plat _____
- 5. Private Claims _____

I, Randy Kolehouse, in a field survey on March 16 19 98, do hereby certify that under requirements of P.A. 74 Michigan P.A. of 1970, the corner points mentioned in lines 1 and 2 above were in conformance with regulations and rules therefore as required in the current manual of survey instructions of the United States Department of the interior, Bureau of Land Management or by a decree of a Court of Law and/or that the corner points mentioned in lines 3, 4 and 5 above were in conformance with the rules of the Michigan Board of Land Surveyors or by a Decree of a Court of Law; established, re-established, monumented, re-monumented, recovered, found as expressed below:

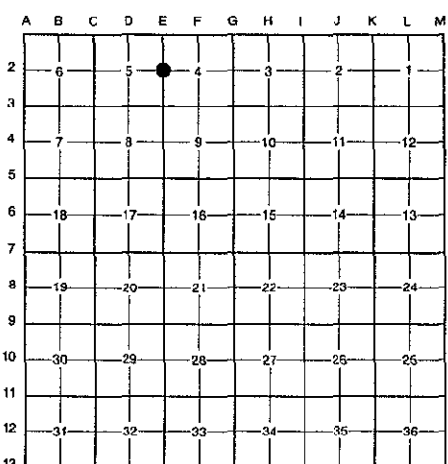

NOTE: Not more than 4 corners, all in the same town and range, may be recorded on this certificate.

A. Description of original monument and accessories and/or subsequent restoration:

E-2	Description	Notes	Surveyor	Monument
1837	G.L.O. Notes	Cathcart	Set Post	
N/A	Witness Map	K.C. Surveyor	Stake & Iron	
1955	Notes	Williams & Works	Set Iron	
1958	Notes	Williams & Works	Iron	
1985	L.C.R.C. #4182	R. Kolehouse	Fnd. 3/4" Iron / Set K.C. Monument	
1994	L.C.R.C. #8010	Glaza & Associates	K.C. Monument	

P.A. 345 1990 KENT COUNTY
 PEER APPROVED 6/29/98
 CHAIRMAN *[Signature]*

This corner was originally approved by the Kent County Remonumentation Peer Group and monumented by Randy Kolehouse on 3/16/85 and was recorded per L.C.R.C. #4182.

B. Description of corner evidence found and/or method applied in restoring or reestablishing corner:

E-2 Found a Standard Kent County Monument on the West side of a 6" steel fence post at the intersection of fence lines running East, West and South per L.C.R.C.'s #4182 and #8010 as set by Randy Kolehouse in place of a 3/4" iron he found which checked the 1955 & 1958 notes of Williams & Works.

L.C.R.C. #4182

L.C.R.C. #8010


- Nail & K.C. Remon. tag in NW side P. Pole (North of 2 poles) N 60° E 122.57'
- Nail & K.C. Remon. tag in P. Pole N 85° E 130.55'
- Nail & K.C. Remon. tag in N. side P. Pole West 169.50'
- Nail & K.C. Remon. tag in W. side 10" W. Cherry S 05° E 156.85'

- Nail & K.C. remon tag in NW side P. pole (N of 2 poles) N60°E 122.57'
- Nail & K.C. remon tag in N side P. pole N85°E 130.55'
- Nail & K.C. remon tag in N side P. pole West 169.50'
- Nail & K.C. remon tag in W side 13" W. Cherry S05°E 156.60'

The selected location is accepted by me and is generally accepted by professional surveyors as the best available evidence of the position of the original corner."

C. Description of monument for corner and accessories established to perpetuate locating the position of the corner:

- E-2 Standard Kent County Monument
- Nail & K.C. remon. tag on NW side P. pole N 60° E 122.68'
 - Nail & K.C. remon. tag on S side P. pole N 85° E 130.7'
 - Nail & K.C. remon. tag on N side P. pole West 169.65'
 - Nail & K.C. remon. tag on W side 13" W. Cherry S 05° E 156.78'
 - On fence lines running E-W-S

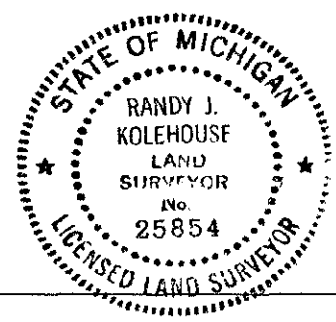

Signed by *Randy J. Kolehouse*
 EARTH TECH

Date 12/14/98

Surveyor's Michigan License No. 25854