

SURVEY & REMONUMENTATION

MAR 08 1999

LAND CORNER RECORDATION CERTIFICATE
Filing Requirement of Act 74, Mich. P.A. 1970
KENT COUNTY REMONUMENTATION

STATE OF MICHIGAN
 COUNTY OF KENT
 RECEIVED FOR RECORD
 98 OCT 23 AM 9:59
 REG. OF DEEDS
Tim Stand

For corners in SECTION

Kent (County)	Located in: Grattan Township	Corner Code #
1. Public Land Survey	T <u>8N</u> R <u>9W</u>	<u>E-5</u>
	T _____ R _____	_____
	T _____ R _____	_____
	T _____ R _____	_____
2. Property Controlling in Section	S _____ T _____ R _____	_____
	S _____ T _____ R _____	_____
3. Miscellaneous Property in Sec.	S _____ T _____ R _____	_____
	S _____ T _____ R _____	_____
4. Lot No. _____, Recorded Plat _____		
5. Private Claims _____		

10854


Register of Deeds Stamp & File Number

I, Randy Kolehouse, in a field survey on March 20 19 98, do hereby certify that under requirements of P.A. 74 Michigan P.A. of 1970, the corner points mentioned in lines 1 and 2 above were in conformance with regulations and rules therefore as required in the current manual of survey instructions of the United States Department of the interior, Bureau of Land Management or by a decree of a Court of Law and/or that the corner points mentioned in lines 3, 4 and 5 above were in conformance with the rules of the Michigan Board of Land Surveyors or by a Decree of a Court of Law; established, re-established, monumented, re-monumented, recovered, found as expressed below:

NOTE: Not more than 4 corners, all in the same town and range, may be recorded on this certificate.

A. Description of original monument and accessories and/or subsequent restoration:

E-5	1837	G.L.O. Notes	Cathcart	Set Post
	1930-54	Witness Map	K.C. Surveyor	Stone
	1980	L.C.R.C. #1420	Moore & Bruggink	Iron
	1981	L.C.R.C. #2011	Jonker Land Survey	Fnd. Iron / Set K.C. Monument
	1994	L.C.R.C. #8015	Glaza & Associates	K.C. Monument

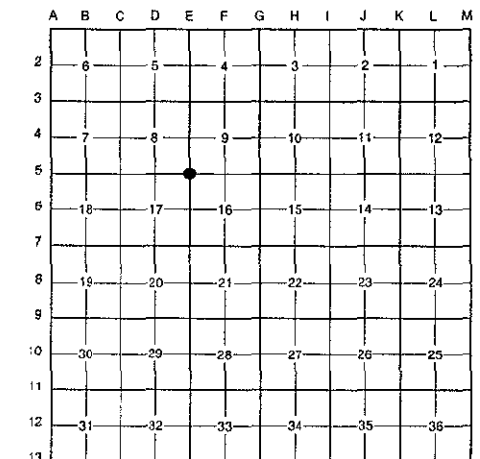

P.A. 345 1990 KENT COUNTY
 PEER APPROVED 6/25/98
 CHAIRMAN *Rob Jonker*

This corner was originally approved by the Kent County Remonumentation Peer Group and monumented by Rob Jonker on 6/12/81 and was recorded per L.C.R.C. #2011.

B. Description of corner evidence found and/or method applied in restoring or reestablishing corner:

E-5	L.C.R.C. #2011	L.C.R.C. #8015
	Remon. tag on W. side 14" Maple S0°E 18.70'	K.C. remon tag & nail in W side 18" Maple S00° 18.68' (m. 18.70')
	Remon. tag on NE side 16" Basswood S45°E 12.90'	K.C. remon tag & nail in NE side 20" Basswood S45°E 12.67' (m. 12.68')
	Remon. tag on N side 6" Tamarack N90°E 17.04'	K.C. remon tag & nail in N side 8" Tamarack N90°E 17.03' (m. 17.07')
	Remon. tag on S side 8" Poplar N90°W 16.38'	K.C. remon tag & nail in S side 14" Poplar N90°W 16.39' (m. 16.36')
	E-W fence line South 8.5'	E-W fence line South 8.5'


The selected location is accepted by me and is generally accepted by professional surveyors as the best available evidence of the position of the original corner.

C. Description of monument for corner and accessories established to perpetuate locating the position of the corner:

E-5 Standard Kent County Monument

- Nail & K.C. remon. tag on W side 18" Maple S 00° E 18.70'
- Nail & K.C. remon. tag on NE side 20" Basswood S 45° E 12.68'
- Nail & K.C. remon. tag on N side 8" Tamarack N 90° E 17.07'
- Nail & K.C. remon. tag on S side 14" Poplar N 90° W 16.36'
- Fence line running E-W, South 8' ±

Signed by *Randy J. Kolehouse* Date 9-1-98
 EARTH TECH

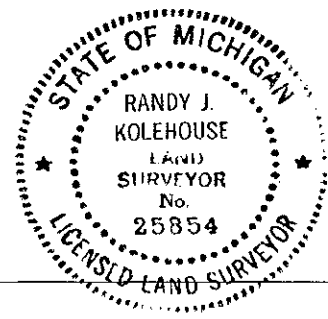

Surveyor's Michigan License No. 25854