

SURVEY & REGIONAL INFORMATION
 \$7.00
 \$2.00
 MAR 08 1999

LAND CORNER RECORDATION CERTIFICATE
Filing Requirement of Act 74, Mich. P.A. 1970
KENT COUNTY REMONUMENTATION

SECTION

For corners in


Kent (County)	Located in:	Grattan Township	Corner Code #
1. Public Land Survey	T <u>8N</u>	R <u>9W</u>	<u>E-6</u>
	T _____	R _____	_____
	T _____	R _____	_____
	T _____	R _____	_____
2. Property Controlling in Section	S _____	T _____	R _____
	S _____	T _____	R _____
3. Miscellaneous Property in Sec.	S _____	T _____	R _____
	S _____	T _____	R _____

STATE OF MICHIGAN
 COUNTY OF KENT
 RECEIVED FOR RECORD
 98 OCT 23 AM 9:59
 REG. OF DEEDS
Randy Kolehouse

10855
 Register of Deeds Stamp & File Number

4. Lot No. _____, Recorded Plat _____
 5. Private Claims _____

I, Randy Kolehouse, in a field survey on February 4 19 98, do hereby certify that under requirements of P.A. 74 Michigan P.A. of 1970, the corner points mentioned in lines 1 and 2 above were in conformance with regulations and rules therefore as required in the current manual of survey instructions of the United States Department of the Interior, Bureau of Land Management or by a decree of a Court of Law and/or that the corner points mentioned in lines 3, 4 and 5 above were in conformance with the rules of the Michigan Board of Land Surveyors or by a Decree of a Court of Law; established, re-established, monumented, re-monumented, recovered, found as expressed below:

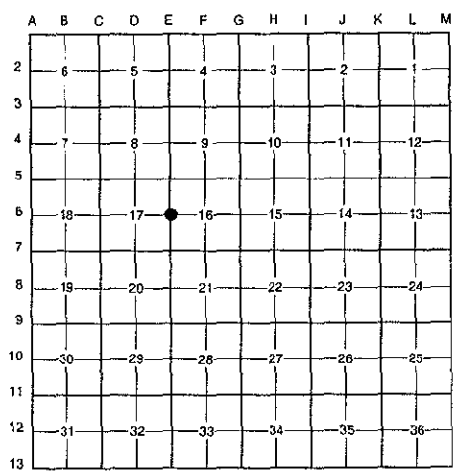

NOTE: Not more than 4 corners, all in the same town and range, may be recorded on this certificate.

A. Description of original monument and accessories and/or subsequent restoration:

E-6	1837	G.L.O. Notes	Cathcart	Set Post
	1927	Notes	Williams & Works	Set Iron
	1959	Notes	Williams & Works	Reset Iron
	1985	L.C.R.C. #4221	R. Kolehouse	Fnd. "T" Iron / Set K.C. Monument
	1994	L.C.R.C. #8016	Glaza & Associates	K.C. Monument

This corner was originally approved by the Kent County Remonumentation Peer Group and monumented by Randy Kolehouse on 5/11/85 and was recorded per L.C.R.C. #4221.

B. Description of corner evidence found and/or method applied in restoring or reestablishing corner:

E-6 Found a Standard Kent County Monument on the C/L of Farmbrook Road (gravel) running North and South, on line of a tree row running West, per L.C.R.C.'s #4221 and #8016 as set by Randy Kolehouse in place of a "T" iron he found on line of occupation running West which also checked the 1927 and 1959 notes of Williams & Works.

L.C.R.C. #4221

L.C.R.C. #8016

Nail & K.C. Remon. tag in W. side 6" Elm N 25° E 39.95'	Nail & K.C. remon tag in W side 6" Elm (stump) N25°E 39.95' (m. 39.93')
Nail & K.C. Remon. tag in NE side 16" Apple N 60° W 60.56'	Nail & K.C. remon tag in NE side 16" Apple N60°W 60.55' (m. 60.53')
	Nail & K.C. remon tag in E side 20" Elm S18°W 134.00' (m. 133.96')


The selected location is accepted by me and is generally accepted by professional surveyors as the best available evidence of the position of the original corner.

C. Description of monument for corner and accessories established to perpetuate locating the position of the corner:

E-6 Standard Kent County Monument

- Nail & K.C. remon. tag on W side 6" Elm stump N 25° E 39.93'
- Nail & K.C. remon. tag on NE side 16" Apple N 60° W 60.53'
- Nail & K.C. remon. tag on E side 20" Elm S 18° W 133.96'
- Nail & K.C. remon. tag on S side 4" Elm S 72° W 20.80'
- Nail & K.C. remon. tag on E side 6" Cherry N 16° W 49.61'
- On C/L of gravel road running N-S
- On tree row running W

P.A. 345 1990 KENT COUNTY
 PEER APPROVED *6/25/98*
 CHAIRMAN *Randy Kolehouse*

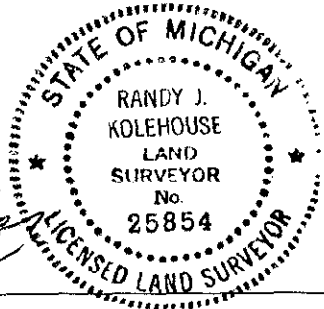

Signed by *Randy J. Kolehouse*
 EARTH TECH

Date *9-1-98*

Surveyor's Michigan License No. 25854