

SURVEYING  
RECORDS

\$7.00  
\$2.00

DEC 06 1993

SECTION

**LAND CORNER RECORDATION CERTIFICATE**  
Filing Requirement of Act 74, Mich. P.A. 1970  
KENT COUNTY REMONUMENTATION

STATE OF MICHIGAN  
COUNTY OF KENT  
RECEIVED FOR RECORD  
98 OCT 23 AM 9:59  
REG. OF DEEDS  
*Eric Sand*

For corners in

Kent (County)	Located in: Grattan Township	Corner Code #
1. Public Land Survey	T <u>8N</u> R <u>9W</u>	<u>E-7</u>
	T _____ R _____	_____
	T _____ R _____	_____
	T _____ R _____	_____
2. Property Controlling in Section	S _____ T _____ R _____	_____
	S _____ T _____ R _____	_____
3. Miscellaneous Property in Sec.	S _____ T _____ R _____	_____
	S _____ T _____ R _____	_____

10856

Register of Deeds Stamp & File Number


4. Lot No. \_\_\_\_\_, Recorded Plat \_\_\_\_\_  
5. Private Claims \_\_\_\_\_

I, Randy Kolehouse, in a field survey on Feb 2 19 98, do hereby certify that under requirements of P.A. 74 Michigan P.A. of 1970, the corner points mentioned in lines 1 and 2 above were in conformance with regulations and rules therefore as required in the current manual of survey instructions of the United States Department of the Interior, Bureau of Land Management or by a decree of a Court of Law and/or that the corner points mentioned in lines 3, 4 and 5 above were in conformance with the rules of the Michigan Board of Land Surveyors or by a Decree of a Court of Law; established, re-established, monumented, re-monumented, recovered, found as expressed below:

**NOTE: Not more than 4 corners, all in the same town and range, may be recorded on this certificate.**

A. Description of original monument and accessories and/or subsequent restoration:

E-7	1837	G.L.O. Notes	Cathcart	Set Post
	1959	Witness Map	K.C. Surveyor	"T" Iron
	1971	L.C.R.C. #97	Williams & Works	"T" Iron
	1981	L.C.R.C. #1878	Jonker Land Survey	Fnd. "T" Iron / Set K.C. Monument
	1989	L.C.R.C. #5239	John Bueche	K.C. Monument (broken)
	1994	L.C.R.C. #8017	Glaza & Associates	K.C. Monument

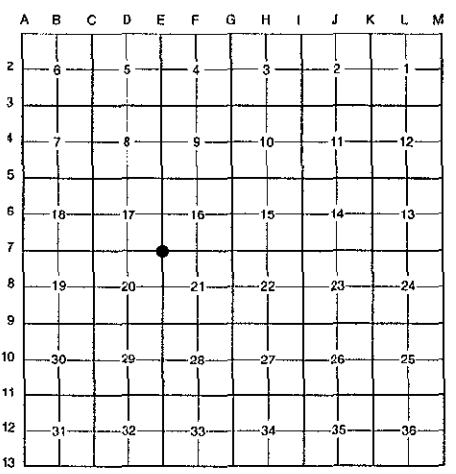

This corner was originally approved by the Kent County Remonumentation Peer Group and monumented by Rob Jonker on 6/4/81 and was recorded per L.C.R.C. #1878.

B. Description of corner evidence found and/or method applied in restoring or reestablishing corner:

E-7 Found a Standard Kent County Monument 7' South of the C/L intersection of 7 Mile Road (gravel) running East and West and Farmbrook Road (gravel) running North per L.C.R.C.'s #1878, #5239 and #7081 as set by Rob Jonker in place of a "T" iron he found which checked L.C.R.C. #97 and the K.C. Surveyor's records.

L.C.R.C. #1878

L.C.R.C. #8017

Remon. tag on N. side 15" oak S60°W 42.95'


- K.C. remon tag & nail in N side 18" Oak S60°W 42.89' (m. 42.85')
- K.C. remon tag & nail in S side P. pole N75°W 79.40' (m. 79.38')
- K.C. remon tag & nail in SE side 4" Oak N45°E 55.17' (m. 55.14')
- K.C. remon tag & nail in SE side P. pole S50°W 24.59' (m. 24.64')
- K.C. remon tag & nail in NE side 10" Oak S32°E 36.11' (m. 35.99')
- C/L "X" of gravel, North 7' +/-

The selected location is accepted by me and is generally accepted by professional surveyors as the best available evidence of the position of the original corner.

C. Description of monument for corner and accessories established to perpetuate locating the position of the corner:

- E-7 Standard Kent County Monument
- Nail & K.C. remon. tag on N side 18" Oak S 60° W 42.85'
  - Nail & K.C. remon. tag on S side P. pole N 75° W 79.38'
  - Nail & K.C. remon. tag on SE side 4" Oak N 45° E 55.14'
  - Nail & K.C. remon. tag on SE side P. pole S 50° W 24.64'
  - Nail & K.C. remon. tag on NE side 10" Oak S 32° E 35.99'
  - C/L "X" of gravel roads running E-W-N, North 7'

P.A. 345 1990 KENT COUNTY  
PEER APPROVED 6/25/98  
CHAIRMAN *[Signature]*

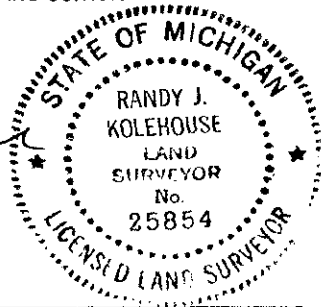

Signed by Randy J. Kolehouse  
EARTH TECH

Date 9-1-98

Surveyor's Michigan License No. 25854