

MAR 08 1999

SECTION

LAND CORNER RECORDATION CERTIFICATE
Filing Requirement of Act 74, Mich. P.A. 1970
KENT COUNTY REMONUMENTATION


For corners in

Kent (County)	Located in:	Grattan Township	Corner Code #
1. Public Land Survey	T <u>8N</u>	R <u>9W</u>	<u>E-8</u>
	T _____	R _____	_____
	T _____	R _____	_____
	T _____	R _____	_____
2. Property Controlling in Section	S _____	T _____	R _____
	S _____	T _____	R _____
3. Miscellaneous Property in Sec.	S _____	T _____	R _____
	S _____	T _____	R _____

STATE OF MICHIGAN
COUNTY OF KENT
RECEIVED FOR RECORD
30 OCT 23 AM 9:59
REG. OF DEEDS
Lucy Stand

10857
Register of Deeds Stamp & File Number

4. Lot No. _____, Recorded Plat _____
5. Private Claims _____

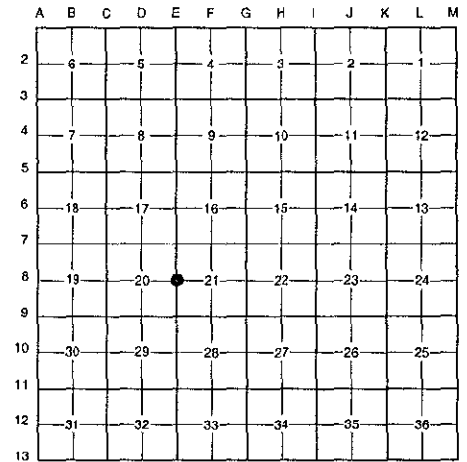

I, Randy Kolehouse, in a field survey on March 25 19 98, do hereby certify that under requirements of P.A. 74 Michigan P.A. of 1970, the corner points mentioned in lines 1 and 2 above were in conformance with regulations and rules therefore as required in the current manual of survey instructions of the United States Department of the Interior, Bureau of Land Management or by a decree of a Court of Law and/or that the corner points mentioned in lines 3, 4 and 5 above were in conformance with the rules of the Michigan Board of Land Surveyors or by a Decree of a Court of Law; established, re-established, monumented, re-monumented, recovered, found as expressed below:

NOTE: Not more than 4 corners, all in the same town and range, may be recorded on this certificate.

A. Description of original monument and accessories and/or subsequent restoration:

E-8	1837	G.L.O. Notes	Cathcart	Set Post
	N/A	Witness Map	K.C. Surveyor	Leaded Stone
	1976	L.C.R.C. #996	Medema, Van Kooten & Assoc.	Set 1-1/4" Iron
	1981	L.C.R.C. #1915	Jonker Land Survey	Fnd. 1-1/4" Iron / Set K.C. Monument
	1994	L.C.R.C. #8018	Glaza & Associates	K.C. Monument

This corner was originally approved by the Kent County Remonumentation Peer Group and monumented by Rob Jonker on 7/16/81 and was recorded per L.C.R.C. #1915.

B. Description of corner evidence found and/or method applied in restoring or reestablishing corner:

E-8 Found a Standard Kent County Monument in a swamp .5' under water per L.C.R.C.'s #1915 and #8018 as set by Rob Jonker in place of a 1-1/4" iron he found which checked L.C.R.C. #996.

L.C.R.C. #1915

- Remon. tag on N side 6" Maple S75°W 10.95'
- Remon. tag on SW side 12" Maple N35°W 35.32'
- Remon. tag on N side 10" Oak S85°E 21.85'
- Remon. tag on E side 6" Maple S10°W 25.83'

L.C.R.C. #8018

- K.C. remon tag & nail in N side 14" Maple S75°W 10.87' (m. 10.91')
- K.C. remon tag & nail in SW side 12" Maple N35°W 35.36' (m. 35.37')
- K.C. remon tag & nail in E side 12" Maple S10°W 25.54' (m. 25.51')
- K.C. remon tag & nail in N side 16" Maple N80°E 12.45' (m. 12.47')
- K.C. remon tag & nail in NW side 10" Oak N52°E 21.62' (m. 21.63')


The selected location is accepted by me and is generally accepted by professional surveyors as the best available evidence of the position of the original corner.

C. Description of monument for corner and accessories established to perpetuate locating the position of the corner:

E-8 Standard Kent County Monument

- Nail & K.C. remon. tag on N side 14" Maple S 75° W 10.91'
- Nail & K.C. remon. tag on SW side 12" Maple N 35° W 35.37'
- Nail & K.C. remon. tag on E side 12" Maple S 10° W 25.51'
- Nail & K.C. remon. tag on N side 16" Maple N 80° E 12.47'
- Nail & K.C. remon. tag on NW side 10" Oak N 52° E 21.63'
- On quarter line running E-W

P.A. 345 1990 KENT COUNTY
PEER APPROVED *6/25/98*
CHAIRMAN *Frank Huber*

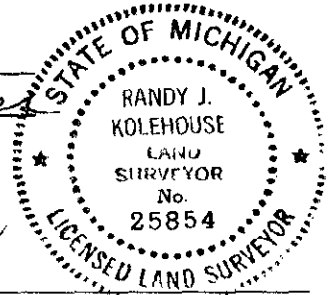

Signed by *Randy J. Kolehouse* Date 9-1-98

EARTHTECH

Surveyor's Michigan License No. 25854