

\$7.00
\$2.00

MAR 08 1999

LAND CORNER RECORDATION CERTIFICATE
Filing Requirement of Act 74, Mich. P.A. 1970
KENT COUNTY REMONUMENTATION

SECTION

STATE OF MICHIGAN
COUNTY OF KENT
RECEIVED FOR RECORD
98 OCT 23 AM 9:59
REG. OF DEEDS
David Stank

10858

Register of Deeds Stamp & File Number

For corners in

Kent
(County)

Located in: Grattan
Township

Corner Code #

- 1. Public Land Survey T 8N R 9W E-9
T _____ R _____
T _____ R _____
T _____ R _____
- 2. Property Controlling in Section S _____ T _____ R _____
S _____ T _____ R _____
- 3. Miscellaneous Property in Sec. S _____ T _____ R _____
S _____ T _____ R _____

- 4. Lot No. _____, Recorded Plat _____
- 5. Private Claims _____

I, Randy Kolehouse, in a field survey on February 2 19 98, do hereby certify that under requirements of P.A. 74 Michigan P.A. of 1970, the corner points mentioned in lines 1 and 2 above were in conformance with regulations and rules therefore as required in the current manual of survey instructions of the United States Department of the interior, Bureau of Land Management or by a decree of a Court of Law and/or that the corner points mentioned in lines 3, 4 and 5 above were in conformance with the rules of the Michigan Board of Land Surveyors or by a Decree of a Court of Law; established, re-established, monumented, re-monumented, recovered, found as expressed below:

NOTE: Not more than 4 corners, all in the same town and range, may be recorded on this certificate.

A. Description of original monument and accessories and/or subsequent restoration:

E-9	1837	G.L.O. Notes	Cathcart	Set Post
	1928	Witness Map	K.C. Surveyor	Leaded Stone
	1975	L.C.R.C. #829	Williams & Works	Concrete Monument per "Point View Plat"
	1981	L.C.R.C. #2012	Jonker Land Survey	Fnd. Plat Monument / Set K.C. Monument
	1994	L.C.R.C. #8019	Glaza & Associates	K.C. Monument

This corner was originally approved by the Kent County Remonumentation Peer Group and monumented by Rob Jonker on 6/12/81 and was recorded per L.C.R.C. #2012.

B. Description of corner evidence found and/or method applied in restoring or reestablishing corner:

E-9 Found a Standard Kent County Monument 33' South of the C/L of Point View Avenue (bit.) running East and West per L.C.R.C.'s #2012 and #8019 as set by Rob Jonker in place of a plat monument he found which checked L.C.R.C. #829.

L.C.R.C. #2012

L.C.R.C. #8019

Remon. tag on S. side p.pole N90°E 122.22'
Remon. tag on E side 22" Oak S45°W 30.50'
Remon. tag on N side 14" Oak S85°W 44.18'
SW corner back of catch basin N45°E 99.05'
C/L Point View Ave. N. 33'

Nail & K.C. remon tag in S side P. pole N88°E 122.14' (m. 122.23')
Nail & K.C. remon tag in E side 28" Oak S36°W 30.45' (m. 30.48')
Nail & K.C. remon tag in N side 18" Oak S83°W 44.18' (m. 44.19')
SW corner back of catch basin N41°E 99.08'
SE corner concrete basement fndn. house #5223 N09°W 112.90' (m. 113.01')
Centerline Point View Avenue North 33'

The selected location is accepted by me and is generally accepted by professional surveyors as the best available evidence of the position of the original corner.

C. Description of monument for corner and accessories established to perpetuate locating the position of the corner:


E-9 Standard Kent County Monument

Nail & K.C. remon. tag on S side P. pole N 88° E 122.23'
Nail & K.C. remon. tag on E side 28" Oak S 36° W 30.48'
Nail & K.C. remon. tag on N side 18" Oak S 83° W 44.19'
SW cor. back of catch basin N 41° E 99.08'
SE cor. conc. basement fndn. to hse. 5223 N 09° W 113.01'
C/L of bit. road running E-W, North 33'

P.A. 345 1990 KENT COUNTY

PEER APPROVED 6/25/98

CHAIRMAN *Randy Kolehouse*

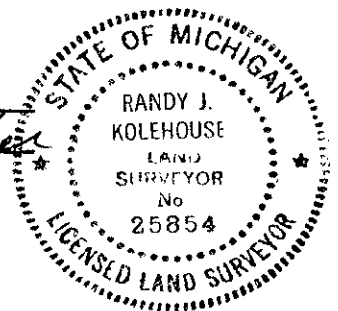

Signed by Randy J. Kolehouse

Date 9-1-98

Surveyor's Michigan License No. 25854