

\$7.00
\$2.00

SECURITY &
REMONUMENTATION

DEC 00 1999

LAND CORNER RECORDATION CERTIFICATE
Filing Requirement of Act 74, Mich. P.A. 1970
KENT COUNTY REMONUMENTATION

For corners in

SECTION

Kent
(County)

Located in: Grattan
Township

Corner Code #

- 1. Public Land Survey T 8N R 9W E-11
T _____ R _____
T _____ R _____
T _____ R _____
- 2. Property Controlling S _____ T _____ R _____
in Section S _____ T _____ R _____
- 3. Miscellaneous S _____ T _____ R _____
Property in Sec. S _____ T _____ R _____

- 4. Lot No. _____, Recorded Plat _____
- 5. Private Claims _____


I, Randy Kolehouse, in a field survey on January 26 19 98, do hereby certify that under requirements of P.A. 74 Michigan P.A. of 1970, the corner points mentioned in lines 1 and 2 above were in conformance with regulations and rules therefore as required in the current manual of survey instructions of the United States Department of the Interior, Bureau of Land Management or by a decree of a Court of Law and/or that the corner points mentioned in lines 3, 4 and 5 above were in conformance with the rules of the Michigan Board of Land Surveyors or by a Decree of a Court of Law; established, re-established, monumented, re-monumented, recovered, found as expressed below:

NOTE: Not more than 4 corners, all in the same town and range, may be recorded on this certificate.

A. Description of original monument and accessories and/or subsequent restoration:

E-11	1837	G.L.O. Notes	Cathcart	Set Post
	1957	Witness Map	K.C. Surveyor	1" Iron in Blacktop
	1972	L.C.R.C. #330	Williams & Works	1" Iron
	1977	L.C.R.C. #1230	William Byl	1" Iron
	1980	L.C.R.C. #1396	Williams & Works	1" Iron
	1981	L.C.R.C. #1882	Jonker Land Survey	Fnd. 3/4" Iron in Mon. Box / Set K.C. Mon. in Mon. Box
	1994	L.C.R.C. #8021	Glaza & Associates	K.C. Monument

P.A. 345 1990 KENT COUNTY
PEER APPROVED 6/25/98
CHAIRMAN [Signature]

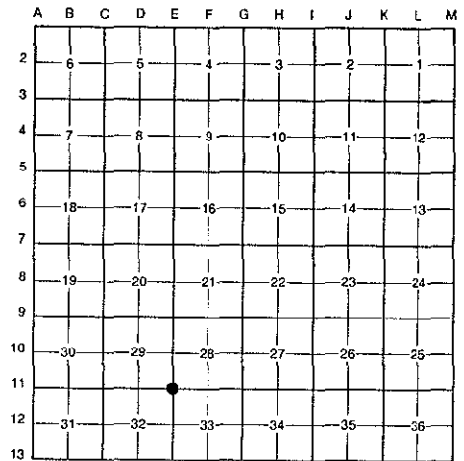

This corner was originally approved by the Kent County Remonumentation Peer Group and monumented by Rob Jonker on 6/4/81 and was recorded per L.C.R.C. #1882.

B. Description of corner evidence found and/or method applied in restoring or reestablishing corner:

E-11 Found a Standard Kent County Monument in a monument box 2' North of the C/L intersection of 5 Mile Road (bit.) running East and West and Murray Lake Road (bit.) running North and South per L.C.R.C.'s #1882 and #8021 as set by Rob Jonker in place of a 3/4" iron he found in a monument box which checked L.C.R.C.'s #1396, #1230, #330 and the K.C. Surveyor's records.

L.C.R.C. #1882

L.C.R.C. #8021


- Remon. tag on S. side p. pole N60°W 65.35'
- Remon. tag on SE side guy pole S70°W 64.63'
- Remon. tag on N side p. pole N80°E 175.72'
- Remon. tag on W side 32" Maple S35°E 120.20'

- K.C. remon tag & nail in S side P. pole N60°W 64.35' (m. 65.36')
- K.C. remon tag & nail in N side P. pole N80°E 175.72' (m. 175.68')
- K.C. remon tag & nail in W side 38" maple S35°E 120.27' (m. 120.27')
- K.C. remon tag & nail in SE side guy pole S75°W 64.83' (m. 64.75')

The selected location is accepted by me and is generally accepted by professional surveyors as the best available evidence of the position of the original corner.

C. Description of monument for corner and accessories established to perpetuate locating the position of the corner:

- E-11 Standard Kent County Monument in a Monument Box
- Nail & K.C. remon. tag on S side P. pole N 60° W 65.36'
- Nail & K.C. remon. tag on N side P. pole N 80° E 175.68'
- Nail & K.C. remon. tag on W side 38" Maple S 35° E 120.27'
- Nail & K.C. remon. tag on SE side Guy pole S 75° W 64.75'
- C/L "X" of bit. roads running N-S-E-W, South 2'

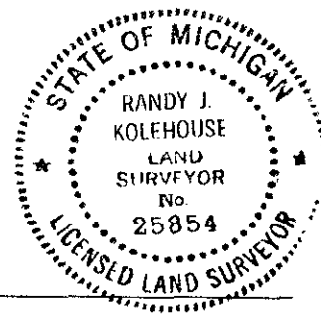

Signed by [Signature] Date 9-1-98

Surveyor's Michigan License No. 25854