

\$7.00
\$2.00

SURVEY & REMONUMENTATION

MAR 08 1999

LAND CORNER RECORDATION CERTIFICATE
Filing Requirement of Act 74, Mich. P.A. 1970
KENT COUNTY REMONUMENTATION

STATE OF MICHIGAN
 COUNTY OF KENT
 RECEIVED FOR RECORD
 38 DEC 14 AM 8:00
 REG. OF DEEDS
Lucy Standa

For corners in


Kent SECTION (County)	Located in:	Grattan Township	Corner Code #
1. Public Land Survey	T 8N	R 9W	E-13
	T	R	
	T	R	
	T	R	
2. Property Controlling in Section	S	T	R
	S	T	R
3. Miscellaneous Property in Sec.	S	T	R
	S	T	R

10972

Register of Deeds Stamp & File Number

4. Lot No. _____, Recorded Plat _____
 5. Private Claims _____

I, Randy Kolehouse, in a field survey on December 31 19 97, do hereby certify that under requirements of P.A. 74 Michigan P.A. of 1970, the corner points mentioned in lines 1 and 2 above were in conformance with regulations and rules therefore as required in the current manual of survey instructions of the United States Department of the interior, Bureau of Land Management or by a decree of a Court of Law and/or that the corner points mentioned in lines 3, 4 and 5 above were in conformance with the rules of the Michigan Board of Land Surveyors or by a Decree of a Court of Law; established, re-established, monumented, re-monumented, recovered, found as expressed below:

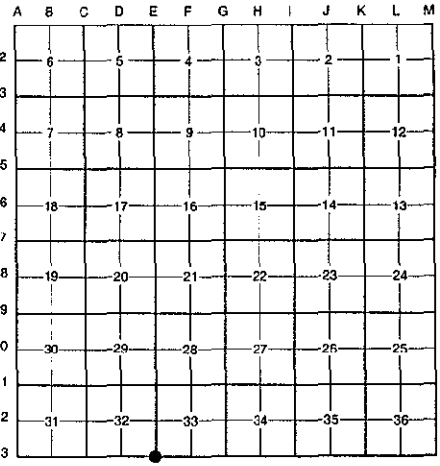

NOTE: Not more than 4 corners, all in the same town and range, may be recorded on this certificate.

A. Description of original monument and accessories and/or subsequent restoration:

E-13	1837	G.L.O. Notes	N. Brookfield	8" Maple
	1940	Witness Map	K.C. Surveyor	Concrete Monument
	1978	Witness Map	K.C. Surveyor	1/2" Iron
	1977	L.C.R.C. #1231	William Byl	Set 1/2" Re-rod & Cap
	1981	L.C.R.C. #1780	Williams & Works	Set K.C. Monument
	1994	L.C.R.C. #8023	Glaza & Associates	K.C. Monument

P.A. 345 1990 KENT COUNTY
 PEER APPROVED 9/24/98
 CHAIRMAN [Signature]

Note: This corner is not common with E-1, T7N, R9W.

This corner was originally approved by the Kent County Remonumentation Peer Group and monumented by Williams & Works on 1/26/81 and was recorded per L.C.R.C. #1780.

B. Description of corner evidence found and/or method applied in restoring or reestablishing corner:

E-13 Found a Standard Kent County Monument 14' West of the C/L of Murray Lake Road (bit.) running North and South and 12' North of the C/L of 4 Mile Road (gravel) running West per L.C.R.C.'s #1780 and #8023 as set by Williams & Works and checked L.C.R.C. #1231 and the K.C. Surveyor's records.

L.C.R.C. #1780

L.C.R.C. #8023

K.C. Remon. Tag & Nail in S. Side Cor. Fe. Post N 60°W 46.30'	K.C. remon tag & nail in S side corner fence post N60°W 46.68' (m. 46.88')
K.C. Remon. Tag & Nail in NE Side P. Pole S 50°E 57.35'	K.C. remon tag & nail in NE side P. pole S50°E 57.35' (m. 57.34')
K.C. Remon. Tag & Nail in N. Side 52" Oak N 75°E 87.95'	K.C. remon tag & nail in N side 52" Oak N75°E 87.43' (m. 87.38')
Top C/L MBT Terminal Box S 25°W 59.30'	Top C/L MBT Terminal Box S25°W 59.25' (m. 59.23')
Conc. Mon. S 90°E 73.90'	K.C. mon. at NE cor. of Sec. 5, T7N, R9W S90°E 73.84' (m. 73.82')

The selected location is accepted by me and is generally accepted by professional surveyors as the best available evidence of the position of the original corner.

C. Description of monument for corner and accessories established to perpetuate locating the position of the corner:

E-13 Standard Kent County Monument	
Nail & K.C. remon. tag on S side cor. fence post (broken) N 60° W 46.88'	C/L of bit. road running N-S, East 14'
Nail & K.C. remon. tag on NE side P. pole S 50° E 57.34'	C/L of gravel road running W, South 12'
Nail & K.C. remon. tag on N side 52" Oak N 75° E 87.38'	K.C. Mon., E-1, T7N, R9W, S 90° E 73.82'
Top C/L MBT terminal box S 25° W 59.23'	
Conc. mon. S 90° E 67.10'	

Signed by Randy J. Kolehouse
 EARTH TECH

Date 9-30-98

Surveyor's Michigan License No. 25854

