

SURVEY & REMONUMENTATION

MAR 08 1999

LAND CORNER RECORDATION CERTIFICATE
Filing Requirement of Act 74, Mich. P.A. 1970
KENT COUNTY REMONUMENTATION

STATE OF MICHIGAN
COUNTY OF KENT
RECEIVED FOR RECORD
38 DEC 14 AM 8:00
REG. OF DEEDS
Tim Stend

For corners in Kent SECTION _____
(County)

Located in: Grattan Township Corner Code #

1. Public Land Survey	T <u>8N</u>	R <u>9W</u>	<u>F-1</u>
	T _____	R _____	_____
	T _____	R _____	_____
	T _____	R _____	_____
2. Property Controlling in Section	S _____	T _____	R _____
	S _____	T _____	R _____
3. Miscellaneous Property in Sec.	S _____	T _____	R _____
	S _____	T _____	R _____

4. Lot No. _____, Recorded Plat _____

5. Private Claims _____

10973
Register of Deeds Stamp & File Number

A	B	C	D	E	F	G	H	I	J	K	L	M
2	6	5	4	3	2	1						
3												
4	7	8	9	10	11	12						
5												
6	16	17	18	19	20	21	22	23	24			
7												
8	19	20	21	22	23	24						
9												
10	30	29	28	27	26	25						
11												
12	31	32	33	34	35	36						
13												

I, Randy Kolehouse, in a field survey on February 5 19 98, do hereby certify that under requirements of P.A. 74 Michigan P.A. of 1970, the corner points mentioned in lines 1 and 2 above were in conformance with regulations and rules therefore as required in the current manual of survey instructions of the United States Department of the Interior, Bureau of Land Management or by a decree of a Court of Law and/or that the corner points mentioned in lines 3, 4 and 5 above were in conformance with the rules of the Michigan Board of Land Surveyors or by a Decree of a Court of Law; established, re-established, monumented, re-monumented, recovered, found as expressed below:

NOTE: Not more than 4 corners, all in the same town and range, may be recorded on this certificate.

A. Description of original monument and accessories and/or subsequent restoration:

F-1	This corner was not originally set by the G.L.O.				
1909-58	Notes	Williams & Works	Iron	P.A. 345 1990 KENT COUNTY	
1985	L.C.R.C. #4113	William Byl	Set K.C. Monument	PEER APPROVED <u>9/24/98</u>	
1989	L.C.R.C. #5218	John Bueche	K.C. Monument	CHAIRMAN <u>Randy Kolehouse</u>	

Note: This corner is not common with F-13, T9N, R9W.

This corner was originally approved by the Kent County Remonumentation Peer Group and monumented by William Byl on 11/1/84 and was recorded per L.C.R.C. #4113.

B. Description of corner evidence found and/or method applied in restoring or reestablishing corner:

F-1 Found a Standard Kent County Monument on the C/L of 10 Mile Road (gravel) running East and West, on line of a fence line and brush row running South, per L.C.R.C.'s #4113 and #5218 as set by William Byl midway between the Northeast and Northwest corner of Section 4 on the South line of Section 33.

L.C.R.C. #4113

L.C.R.C. #5218


Nail & tag, S sd. Fence post N 60° W 69.42'
Nail & tag, E sd. Fence post S 10° W 33.70'
S1/4 cor. Sec. 33 (F-13) N 90° E 146.00'

Nail & Remon Tag S side fence post N 60° W 69.30' (m. 69.35')
Nail & Remon Tag E side fence post S 10° W 33.70'
K.C. Mon. in Mon. Box, (F-13, 9-9) East 146.00'

The selected location is accepted by me and is generally accepted by professional surveyors as the best available evidence of the position of the original corner.

C. Description of monument for corner and accessories established to perpetuate locating the position of the corner:

F-1 Standard Kent County Monument
Nail & K.C. remon. tag on S side fence post N 60° W 69.35'
Nail & K.C. remon. tag on E side fence post S 10° W 33.70'
Nail & K.C. remon. tag on S side wood fence post N 72° E 150.15'
Nail & K.C. remon. tag on SW side 6" Maple S 35° E 36.15'
On C/L of gravel road running E-W
On fence line and brush row running S
K.C. Mon., F-13, T9N, R9W, East 146.00'

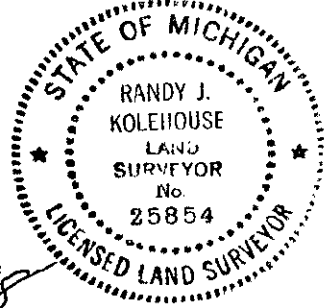

Signed by Randy J. Kolehouse Date 9-30-98
EARTH TECH
Surveyor's Michigan License No. 25854