

STATE OF MICHIGAN
COUNTY OF KENT
RECEIVED FOR RECORD

93 MAY 13 AM 9:07

Thomas Starr
REG. OF DEEDS

Kent County Remonumentation
LAND CORNER RECORDATION CERTIFICATE
Filing Requirement of Act 74, Mich. P.A. 1970

For corners in

Kent

(County)

Located In:
Grattan Twp.

Corner Code --#

- | | | |
|------------------------------------|---------------------------|---------------------|
| 1. Public Land Survey | T <u>8-N</u> R <u>9-W</u> | <u>F-4</u> |
| | T _____ R _____ | <u>Cent. Sec #9</u> |
| | T _____ R _____ | _____ |
| | T _____ R _____ | _____ |
| 2. Property Controlling in Section | S _____ T _____ R _____ | _____ |
| | S _____ T _____ R _____ | _____ |
| 3. Miscellaneous Property in Sec. | S _____ T _____ R _____ | _____ |
| | S _____ T _____ R _____ | _____ |

6771

Register of Deeds Stamp & File Number

4. Lot No. _____, Recorded Plat _____
5. Private Claims _____

I, Thomas Starr, in a field survey on March 15, 1993, do hereby certify that under requirements of P.A. 74, Michigan P.A. of 1970, the corner points mentioned in lines 1 and 2 above were in conformance with regulations and rules therefore as required in the current manual of survey instructions of the United States Department of the Interior, Bureau of Land Management or by a decree of a Court of Law and/or that the corner points mentioned in lines 3, 4 and 5 above were in conformance with the rules of the Michigan Board of Land Surveyors or by a Decree of a Court of Law; established, re-established, monumented, re-monumented, recovered, found as expressed below:

NOTE: Not more than 4 corners, all in the same town and range, may be recorded on this certificate.

A. Description of original monument and accessories and/or subsequent restoration:
F-4


No Record of Corner.

B. Description of corner evidence found and/or method applied in restoring or reestablishing corner:

F-4

Located by intersecting 1/4 lines.
For Section 9 - Sectional Survey

See Recorded Survey - Liber 253, Page 72.

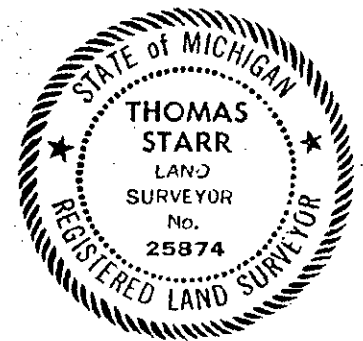

C. Description of monument for corner and accessories established to perpetuate locating the position of the corner:

F-4 - Set Standard Kent County Harrison Monument.

Witness

Nail & Tag in W. side 12" Ash	S15°W	49.91'
Nail & Tag in W. side 28" Oak	S10°E	42.82'
Nail & Tag in E. side wood fence post	S40°E	13.77'
Nail & Tag in S. side 6" Pine	S60°E	39.75'
property corner iron	South	16.50'
17.6' North to the South edge of bituminous race track		
9' East to fence line South - 10' South to fence line East		

Signed by

Thomas C. Starr

Date

5-11-93

Surveyor's Michigan License No. 25874