

\$7.00
\$2.00

RECORDATION

OCT 08 1998

LAND CORNER RECORDATION CERTIFICATE
Filing Requirement of Act 74, Mich. P.A. 1970
KENT COUNTY REMONUMENTATION

For corners in

SECTION

Kent (County)	Located in:	Grattan Township	Corner Code #
1. Public Land Survey	T <u>8N</u>	R <u>9W</u>	<u>F-5</u>
	T _____	R _____	_____
	T _____	R _____	_____
	T _____	R _____	_____
2. Property Controlling in Section	S _____	T _____	R _____
	S _____	T _____	R _____
3. Miscellaneous Property in Sec.	S _____	T _____	R _____
	S _____	T _____	R _____

STATE OF MICHIGAN
COUNTY OF KENT
RECEIVED FOR RECORD


98 OCT 23 AM 9:59

REG. OF DEEDS
[Signature]
10862

Register of Deeds Stamp & File Number

4. Lot No. _____, Recorded Plat _____
5. Private Claims _____

I, Flandy Kolehouse, in a field survey on March 16 19 98, do hereby certify that under requirements of P.A. 74 Michigan P.A. of 1970, the corner points mentioned in lines 1 and 2 above were in conformance with regulations and rules therefore as required in the current manual of survey instructions of the United States Department of the interior, Bureau of Land Management or by a decree of a Court of Law and/or that the corner points mentioned in lines 3, 4 and 5 above were in conformance with the rules of the Michigan Board of Land Surveyors or by a Decree of a Court of Law; established, re-established, monumented, re-monumented, recovered, found as expressed below:

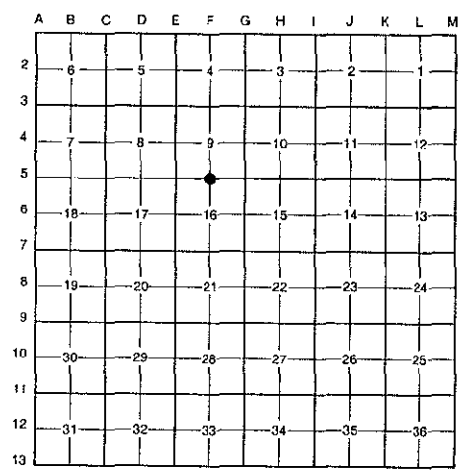

NOTE: Not more than 4 corners, all in the same town and range, may be recorded on this certificate.

A. Description of original monument and accessories and/or subsequent restoration:

F-5	1837	G.L.O. Notes	Cathcart	Set Post
	1887	Notes	Williams & Works	West - 2646.60'; East - 2651.88'
	N/A	Witness Map	K.C. Surveyor	West - 2647'; East 2653'
	1991	L.C.R.C. #5749	T. Chettleburgh	Set K.C. Monument
	1995	L.C.R.C. #8028	Glaza & Associates	K.C. Monument

P.A. 345 1990 KENT COUNTY
PEER APPROVED 6/25/98
CHAIRMAN *[Signature]*

This corner was originally approved by the Kent County Remonumentation Peer Group and monumented by T. Chettleburgh on 2/11/98 and was recorded per L.C.R.C. #5749.

B. Description of corner evidence found and/or method applied in restoring or reestablishing corner:


F-5 Found a Standard Kent County Monument in a farmer's apple field (no occupation line) per L.C.R.C.'s #5749 and #8028 as set by T. Chettleburgh 16" deep in farm field on straight line between E-5 and G-5 in proportion to Williams & Works' 1887 measurements. Also checked the K.C. Surveyor's records.

L.C.R.C. #5749	L.C.R.C. #8028
KC Remon tag in NW side of 12" Oak N54°E 206.04'	K.C. remon tag & nail in NW side 15" Oak N54°E 206.03' (m. 206.00')
KC Remon tag in SE side of 28" Oak N73°E 317.77'	K.C. remon tag & nail in SE side 33" Oak N73°E 317.78' (m. 317.82')
KC Remon tag in S. side of 18" W. Cherry N63°W 228.06'	K.C. remon tag & nail in S side 20" W. Cherry N63°W 228.01' (m. 228.00')
KC Remon tag in NE side of 12" W. Cherry N39°W 230.11'	K.C. remon tag & nail in NE side 12" W. Cherry N39°W 230.11' (m. 230.15')
KC Remon tag in E. side of 8" W. Cherry N09°W 147.58'	K.C. remon tag & nail in E side 10" W. Cherry N09°W 147.60' (m. 147.63')
KC Remon tag in E. side of 13" Elm N03°W 160.23'	K.C. remon tag & nail in E side 13" Elm N03°W 160.22' (m. 160.25')

The selected location is accepted by me and is generally accepted by professional surveyors as the best available evidence of the position of the original corner.

C. Description of monument for corner and accessories established to perpetuate locating the position of the corner:

- F-5 Standard Kent County Monument
- Nail & K.C. remon. tag on NW side 15" Oak N 54° E 206.00'
 - Nail & K.C. remon. tag on SE side 33" Oak N 73° E 317.82'
 - Nail & K.C. remon. tag on S side 20" W. Cherry N 63° W 228.00'
 - Nail & K.C. remon. tag on NE side 12" W. Cherry N 39° W 230.15'
 - Nail & K.C. remon. tag on E side 10" W. Cherry N 09° W 147.63'
 - Nail & K.C. remon. tag on E side 14" Elm N 03° W 160.25'

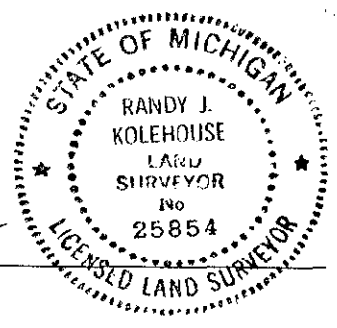

Signed by *[Signature]* Date 9-1-98
EARTH TECH
Surveyor's Michigan License No. 25854