

**SURVEY & REMONUMENTATION**

\$7.00  
\$2.00

MAR 9 8 1999

**LAND CORNER RECORDATION CERTIFICATE**

Filing Requirement of Act 74, Mich. P.A. 1970

KENT COUNTY REMONUMENTATION

For corners in

SECTION

Kent (County)	Located in:	Grattan Township	Corner Code #
1. Public Land Survey	T <u>8N</u>	R <u>9W</u>	F-6
	T _____	R _____	_____
	T _____	R _____	_____
	T _____	R _____	_____
2. Property Controlling in Section	S _____	T _____	R _____
	S _____	T _____	R _____
3. Miscellaneous Property in Sec.	S _____	T _____	R _____
	S _____	T _____	R _____

STATE OF MICHIGAN  
COUNTY OF KENT  
RECEIVED FOR RECORD  
38 DEC 14 AM 8:00  
REG. OF DEEDS  
*W. J. ...*

11044

Register of Deeds Stamp & File Number

4. Lot No. \_\_\_\_\_, Recorded Plat \_\_\_\_\_  
5. Private Claims \_\_\_\_\_

I, Randy Kolehouse, in a field survey on November 23 19 98, do hereby certify that under requirements of P.A. 74 Michigan P.A. of 1970, the corner points mentioned in lines 1 and 2 above were in conformance with regulations and rules therefore as required in the current manual of survey instructions of the United States Department of the interior, Bureau of Land Management or by a decree of a Court of Law and/or that the corner points mentioned in lines 3, 4 and 5 above were in conformance with the rules of the Michigan Board of Land Surveyors or by a Decree of a Court of Law; established, re-established, monumented, re-monumented, recovered, found as expressed below:

	A	B	C	D	E	F	G	H	I	J	K	L	M
2	6		5		4		3		2		1		
3													
4	7		8		9		10		11		12		
5													
6	15		17		16		15		14		13		
7													
8	19		20		21		22		23		24		
9													
10	30		29		28		27		26		25		
11													
12	31		32		33		34		35		36		
13													

NOTE: Not more than 4 corners, all in the same town and range, may be recorded on this certificate.


A. Description of original monument and accessories and/or subsequent restoration:  
F-6 This corner was not originally set by the G.L.O.  
Found no information on record for this corner.

P.A. 345 1990 KENT COUNTY  
PEER APPROVED 11/12/98  
CHAIRMAN *[Signature]*

B. Description of corner evidence found and/or method applied in restoring or reestablishing corner:  
F-6 Set a monument at the intersection of 1/4 lines. Monument is in the middle of a swamp 100' ± West of a 2-track running North and South and 2' West of a downed fence line running North and South.

The selected location is accepted by me and is generally accepted by professional surveyors as the best available evidence of the position of the original corner.

C. Description of monument for corner and accessories established to perpetuate locating the position of the corner:  
F-6 Set a Standard Kent County Monument  
Nail & K.C. remon. tag on S face 8" Maple N 65° E 9.58'  
Nail & K.C. remon. tag on W face 6" Ash S 20° W 12.30'  
Nail & K.C. remon. tag on SE face 8" Ash S 58° W 20.70'  
Nail & K.C. remon. tag on SW face 6" Maple N 45° W 18.21'  
2-track running N-S, East 100' ±  
Downed fence line running N-S, East 2'

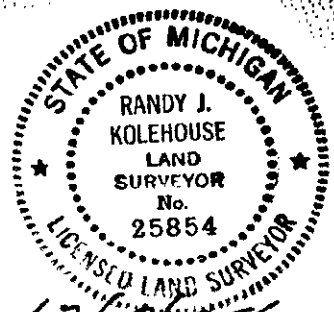

Signed by *Randy J. Kolehouse* Date 12/4/98  
EARTH TECH  
Surveyor's Michigan License No. 25854