

MICHIGAN
REMONUMENTATION

\$7.00
\$2.00

SEP 08 1999

LAND CORNER RECORDATION CERTIFICATE
Filing Requirement of Act 74, Mich. P.A. 1970
KENT COUNTY REMONUMENTATION

STATE OF MICHIGAN
COUNTY OF KENT
RECEIVED FOR RECORD
98 OCT 23 AM 9:59
REG. OF DEEDS
Randy Kolehuse

For corners in

SECTION


Kent (County)	Located in:	Grattan Township	Corner Code #
1. Public Land Survey	T <u>8N</u>	R <u>9W</u>	<u>E-7</u>
	T _____	R _____	_____
	T _____	R _____	_____
	T _____	R _____	_____
2. Property Controlling in Section	S _____	T _____	R _____
	S _____	T _____	R _____
3. Miscellaneous Property in Sec.	S _____	T _____	R _____
	S _____	T _____	R _____

10863

Register of Deeds Stamp & File Number

4. Lot No. _____, Recorded Plat _____
5. Private Claims _____

I, Randy Kolehuse, in a field survey on February 3 19 98, do hereby certify that under requirements of P.A. 74 Michigan P.A. of 1970, the corner points mentioned in lines 1 and 2 above were in conformance with regulations and rules therefore as required in the current manual of survey instructions of the United States Department of the interior, Bureau of Land Management or by a decree of a Court of Law and/or that the corner points mentioned in lines 3, 4 and 5 above were in conformance with the rules of the Michigan Board of Land Surveyors or by a Decree of a Court of Law; established, re-established, monumented, re-monumented, recovered, found as expressed below:

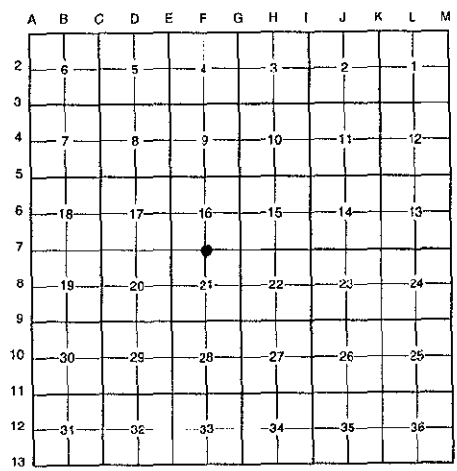

NOTE: Not more than 4 corners, all in the same town and range, may be recorded on this certificate.

A. Description of original monument and accessories and/or subsequent restoration:

F-7	1837	G.L.O. Notes	Cathcart	Set Post
	N/A	Witness Map	K.C. Surveyor	Leaded Stone
	1976	L.C.R.C. #997	Medema, Van Kooten & Assoc.	Set 3/4" Iron
	1981	L.C.R.C. #1877	Jonker Land Survey	Fnd. 3/4" Iron / Set K.C. Monument
	1994	L.C.R.C. #8029	Glaza & Associates	K.C. Monument

This corner was originally approved by the Kent County Remonumentation Peer Group and monumented by Rob Jonker on 6/4/81 and was recorded per L.C.R.C. #1877.

B. Description of corner evidence found and/or method applied in restoring or reestablishing corner:

F-7 Found a Standard Kent County Monument 4' North of the C/L of 7 Mile Road (gravel) running East and West, on line of a tree row running North, per L.C.R.C.'s #1877 and #8029 as set by Rob Jonker in place of a 3/4" iron he found which checked L.C.R.C. #997.

L.C.R.C. #1877

L.C.R.C. #8029

Remon. tag on S side tw. 10" Oak S70°W 74.00
C/L E-W gravel is 4'S
In line with edge of field-North

K.C. remon tag & nail in E side 10" Oak N00°E 27.94' (m. 27.93')
K.C. remon tag & nail in SW side 9" Hickory N47°W 39.09' (m. 39.52')
K.C. remon. tag & nail in SW side 8" Oak S45°E 44.09' (m. 44.17')
All Points capped iron S00°W 32.11' (m. 33.05')
C/L E-W gravel is 4' South
In line with edge of field - North


The selected location is accepted by me and is generally accepted by professional surveyors as the best available evidence of the position of the original corner.

C. Description of monument for corner and accessories established to perpetuate locating the position of the corner:

F-7 Standard Kent County Monument

- Nail & K.C. remon. tag on E side 10" Oak N 00° E 27.93'
- Nail & K.C. remon. tag on SW side 9" Hickory N 47° W 39.52'
- Nail & K.C. remon. tag on SW side 8" Oak S 45° E 44.17'
- All Points capped iron S 00° W 33.05'
- C/L of gravel road running E-W, South 4'
- On tree row running N

P.A. 345 1990 KENT COUNTY
PEER APPROVED 6/25/98
CHAIRMAN Randy Kolehuse

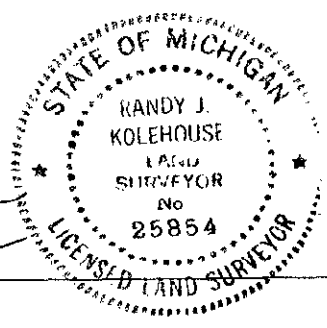

Signed by Randy J. Kolehuse Date 9-1-98

EARTHTECH

Surveyor's Michigan License No. 25854