

\$7.00
\$2.00

MAR 08 1989

LAND CORNER RECORDATION CERTIFICATE
Filing Requirement of Act 74, Mich. P.A. 1970
KENT COUNTY REMONUMENTATION

For corners in SECTION

Kent (County)	Located in: Grattan Township	Corner Code #
1. Public Land Survey	T <u>8N</u> R <u>9W</u>	<u>F-9</u>
	T _____ R _____	_____
	T _____ R _____	_____
	T _____ R _____	_____
2. Property Controlling in Section	S _____ T _____ R _____	_____
	S _____ T _____ R _____	_____
3. Miscellaneous Property in Sec.	S _____ T _____ R _____	_____
	S _____ T _____ R _____	_____

STATE OF MICHIGAN
COUNTY OF KENT
RECEIVED FOR RECORD
39 OCT 23 AM 9:59
REG. OF DEEDS
Lucy Bond


10864

Register of Deeds Stamp & File Number

- 4. Lot No. _____, Recorded Plat _____
- 5. Private Claims _____

I, Randy Kolehouse, in a field survey on February 2 19 98, do hereby certify that under requirements of P.A. 74 Michigan P.A. of 1970, the corner points mentioned in lines 1 and 2 above were in conformance with regulations and rules therefore as required in the current manual of survey instructions of the United States Department of the interior, Bureau of Land Management or by a decree of a Court of Law and/or that the corner points mentioned in lines 3, 4 and 5 above were in conformance with the rules of the Michigan Board of Land Surveyors or by a Decree of a Court of Law; established, re-established, monumented, re-monumented, recovered, found as expressed below:

NOTE: Not more than 4 corners, all in the same town and range, may be recorded on this certificate.

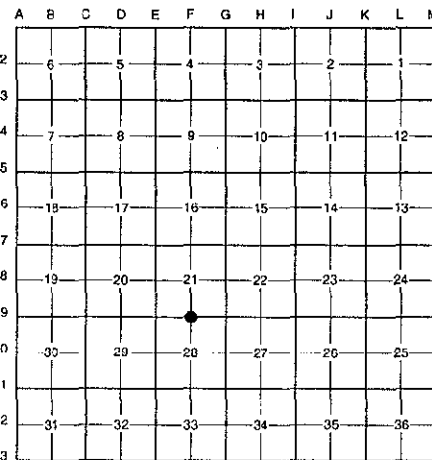

A. Description of original monument and accessories and/or subsequent restoration:

F-9	1837	G.L.O. Notes	Cathcart	Set Post
	1947	Witness Map	K.C. Surveyor	1" Iron
	1976	L.C.R.C. #997	Medema, Van Kooten & Assoc.	3/4" Iron
	1981	L.C.R.C. #1872	Jonker Land Survey	Fnd. 3/4" Iron / Set K.C. Monument
	1994	L.C.R.C. #8030	Glaza & Associates	K.C. Monument

P.A. 345 1990 KENT COUNTY
PEER APPROVED 6/25/98
CHAIRMAN Randy Kolehouse

This corner was originally approved by the Kent County Remonumentation Peer Group and monumented by Rob Jonker on 6/11/81 and was recorded per L.C.R.C. #1872.

B. Description of corner evidence found and/or method applied in restoring or reestablishing corner:

F-9 Found a Standard Kent County Monument 2' North of the C/L of 6 Mile Road (gravel) running East and West and 500' ± West of the C/L of Murray Lake Road (gravel) running South per L.C.R.C.'s #1872 and #8030 as set by Rob Jonker in place of a 3/4" round iron he found along side of a 1-1/2"x9" crimped iron which checked L.C.R.C. #997.

L.C.R.C. #1872

Remon. tag on E side 14" maple S43°W 36.3'
Remon. tag on E side 12" ash S03°E 64.22'
Remon. tag on W side 16" ash N33°W 62.97'
On C.L. gravel

L.C.R.C. #8030

K.C. remon tag & nail in E side 14" Maple S43°W 36.09'
K.C. remon tag & nail in E side 14" Ash S03°E 64.19' (m. 64.18')
K.C. remon tag & nail in W side 24" Ash N33°W 62.77' (m. 62.73')
K.C. remon tag & nail in N side 6" Elm S45°E 55.78' (m. 55.81')

The selected location is accepted by me and is generally accepted by professional surveyors as the best available evidence of the position of the original corner.


C. Description of monument for corner and accessories established to perpetuate locating the position of the corner:

F-9 Standard Kent County Monument

Nail & K.C. remon. tag on E side 14" Maple S 43° W 36.09'
Nail & K.C. remon. tag on E side 14" Ash S 03° E 64.18'
Nail & K.C. remon. tag on W side 24' Ash N 33° W 62.73'
Nail & K.C. remon. tag on N side 6" Elm S 45° E 55.81
C/L of gravel road running E-W, South 2'
C/L of gravel road running S, East 500' ±

Signed by Randy J. Kolehouse
EARTH TECH

Date 9-1-98

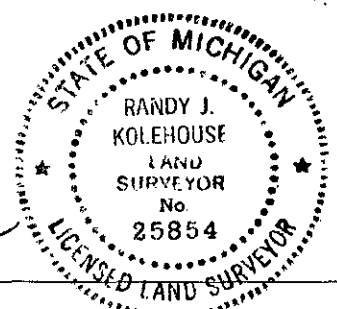

Surveyor's Michigan License No. 25854