

MAR 08 1999

\$7.00
\$2.00

SECTION

LAND CORNER RECORDATION CERTIFICATE

Filing Requirement of Act 74, Mich. P.A. 1970

KENT COUNTY REMONUMENTATION

For corners in

Kent (County)	Located in: Grattan Township	Corner Code #
1. Public Land Survey	T <u>8N</u> R <u>9W</u>	<u>F-10</u>
	T _____ R _____	_____
	T _____ R _____	_____
	T _____ R _____	_____
2. Property Controlling in Section	S _____ T _____ R _____	_____
	S _____ T _____ R _____	_____
3. Miscellaneous Property in Sec.	S _____ T _____ R _____	_____
	S _____ T _____ R _____	_____

STATE OF MICHIGAN
COUNTY OF KENT
RECEIVED FOR RECORD

98 DEC 14 AM 8:00


REG. OF DEEDS

W. J. Colehouse

10974

Register of Deeds Stamp & File Number

- 4. Lot No. _____, Recorded Plat _____
- 5. Private Claims _____

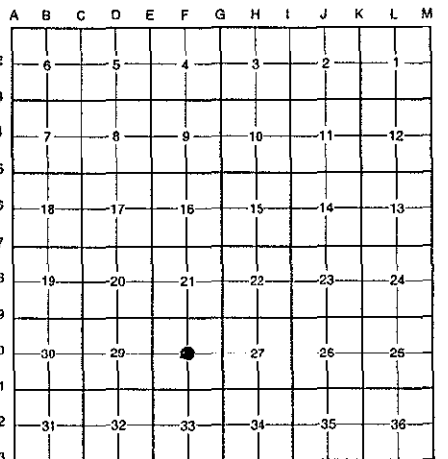

I, Randy Kolehouse, in a field survey on March 10 19 98, do hereby certify that under requirements of P.A. 74 Michigan P.A. of 1970, the corner points mentioned in lines 1 and 2 above were in conformance with regulations and rules therefore as required in the current manual of survey instructions of the United States Department of the interior, Bureau of Land Management or by a decree of a Court of Law and/or that the corner points mentioned in lines 3, 4 and 5 above were in conformance with the rules of the Michigan Board of Land Surveyors or by a Decree of a Court of Law; established, re-established, monumented, re-monumented, recovered, found as expressed below:

NOTE: Not more than 4 corners, all in the same town and range, may be recorded on this certificate.

A. Description of original monument and accessories and/or subsequent restoration:

F-10	This corner was not originally set by the G.L.O.		
1941	Witness Map	K.C. Surveyor	Concrete Monument
1959	Survey Records	Williams & Works	Concrete Monument

P.A. 345 1998 KENT COUNTY
PEER APPROVED 10/22/98
CHAIRMAN *Stan Huber*

B. Description of corner evidence found and/or method applied in restoring or reestablishing corner:


F-10 Found a concrete monument with a 1" pipe on the C/L of Murray Lake Road (gravel) extended East 50' ± per the Kent County Surveyor's records. Monument and iron are 0.1' West and 0.4' North of the intersection of 1/4 lines. Accepted monument and iron as Center of Section.

The selected location is accepted by me and is generally accepted by professional surveyors as the best available evidence of the position of the original corner.

C. Description of monument for corner and accessories established to perpetuate locating the position of the corner:

F-10 Replaced Concrete Monument and Iron with a Standard Kent County Monument

- Nail & K.C. remon. tag on S side 24" Oak N 81° E 31.04'
- Nail & K.C. remon. tag on N side twin 16" Oaks S 60° E 31.14'
- Nail & K.C. remon. tag on W side 10" Elm N 10° E 34.34'
- Nail & K.C. remon. tag on W side 20" Oak S 02° E 30.85'
- Nail & K.C. remon. tag on E side 8" W. Cherry S 02° W 26.62'
- Nail & K.C. remon. tag on E side 8" Oak S 30° W 30.06'

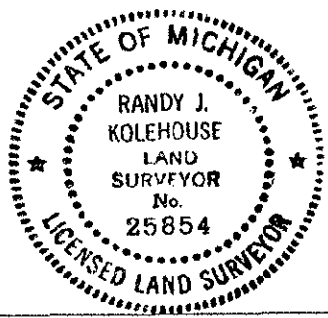

Signed by *Randy J. Kolehouse* Date 11/18/98

Surveyor's Michigan License No. 25854