

\$7.00
\$2.00
MAY 08 1999


LAND CORNER RECORDATION CERTIFICATE
Filing Requirement of Act 74, Mich. P.A. 1970
KENT COUNTY REMONUMENTATION

For corners in

<u>Kent</u> (County)	<u>SECTION</u>	Located in: Grattan Township	Corner Code #
1. Public Land Survey	T <u>8N</u> R <u>9W</u>		<u>G-2</u>
	T _____ R _____		_____
	T _____ R _____		_____
	T _____ R _____		_____
2. Property Controlling in Section	S _____ T _____ R _____		_____
	S _____ T _____ R _____		_____
3. Miscellaneous Property in Sec.	S _____ T _____ R _____		_____
	S _____ T _____ R _____		_____
4. Lot No. _____, Recorded Plat _____			
5. Private Claims _____			

STATE OF MICHIGAN
 COUNTY OF KENT
 RECEIVED FOR RECORD
 98 OCT 23 AM 9:59
 REG. OF DEEDS
David Stand
 10867
 Register of Deeds Stamp & File Number

I, Randy Kolehouse, in a field survey on March 16 19 98, do hereby certify that under requirements of P.A. 74 Michigan P.A. of 1970, the corner points mentioned in lines 1 and 2 above were in conformance with regulations and rules therefore as required in the current manual of survey instructions of the United States Department of the interior, Bureau of Land Management or by a decree of a Court of Law and/or that the corner points mentioned in lines 3, 4 and 5 above were in conformance with the rules of the Michigan Board of Land Surveyors or by a Decree of a Court of Law; established, re-established, monumented, re-monumented, recovered, found as expressed below:

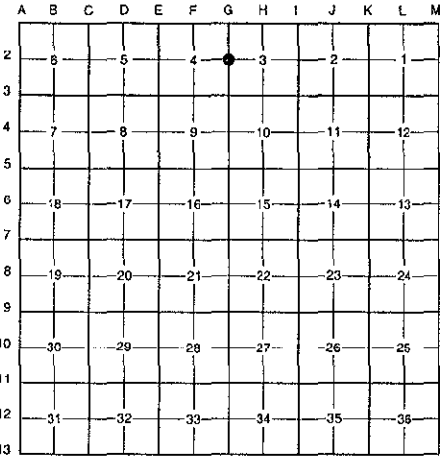

NOTE: Not more than 4 corners, all in the same town and range, may be recorded on this certificate.

A. Description of original monument and accessories and/or subsequent restoration:

G-2	1837	G.L.O. Notes	Cathcart	Set Post
	1956	Witness Map	K.C. Surveyor	Iron
	1982	L.C.R.C. #2638	C. Fricke	Concrete Monument and 1/2" Rerod
	1982	L.C.R.C. #2867	Jonker Land Survey	Fnd. Plat Monument / Set K.C. Monument
	1994	L.C.R.C. #8033	Glaza & Associates	K.C. Monument

This corner was originally approved by the Kent County Remonumentation Peer Group and monumented Rob Jonker on 5/18/82 and was recorded per L.C.R.C. #2867.

B. Description of corner evidence found and/or method applied in restoring or reestablishing corner:


G-2	Found a Standard Kent County Monument on line of a tree row running South and 50' ± Northwest of a bend in 2-track running South and East per L.C.R.C.'s #2867 and #8033 as set by Rob Jonker in place of a 4"x36" plat monument he found which checked L.C.R.C. #2638.
-----	---

L.C.R.C. #2867	L.C.R.C. #8033
Remon. tag on SE side 20" Ash N55°E 20.71'	K.C. remon tag & nail in SE side 26" Ash N55°E 20.73'
Remon. tag on N side 9" Hickory S85°W 28.70'	K.C. remon tag & nail in N side 12" Hickory S85°W 28.68' (m. 28.69')
Remon. tag on NE side 9" W. Cherry N60°W 18.68'	K.C. remon tag & nail in NE side 10" W. Cherry N60°W 18.62' (m. 18.63')
C/L MH S35°E 25.93'	C/L MH S35°E 25.93'

The selected location is accepted by me and is generally accepted by professional surveyors as the best available evidence of the position of the original corner.

C. Description of monument for corner and accessories established to perpetuate locating the position of the corner:

G-2	Standard Kent County Monument	P.A. 345 1990 KENT COUNTY PEER APPROVED 6/25/98 CHAIRMAN <i>Randy Kolehouse</i>
	Nail & K.C. remon. tag on SE side 26" Ash N 55° E 20.73'	
	Nail & K.C. remon. tag on N side 12" Hickory S 85° W 28.69'	
	Nail & K.C. remon. tag on NE side 10" W. Cherry N 60° W 18.63'	
	M.H. (no cover) S 35° E 25.93'	
	Nail & K.C. remon. tag on E side 18" Maple S 25° W 10.88'	
	Nail & K.C. remon. tag on NE side 14" Maple S 38° E 11.69'	
	On tree row running S	

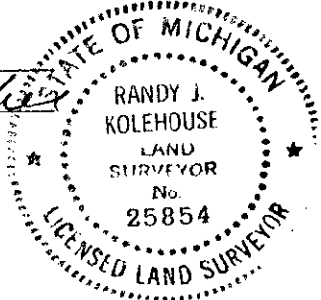

Signed by *Randy J. Kolehouse* Date 9-1-98
 EARTH TECH
 Surveyor's Michigan License No. 25854